WATER SERVICE RECORD

Name

Service No. 2320

Address 35 Cary AVE

Location

Repair—Renewal—New Service J Mclaughlin

Date		Material	Amount		Total		Date		Exist	Amount	
11/14/06	71'	1" Copper					9/5/96	14'	1" Copper		
		buffalo box							1" Corp		
									1" Curb Stop		

DATE _____

TOWN OF LEXINGTON — BOARD OF PUBLIC WORKS

WATER DIVISION

Sketch of Service Here

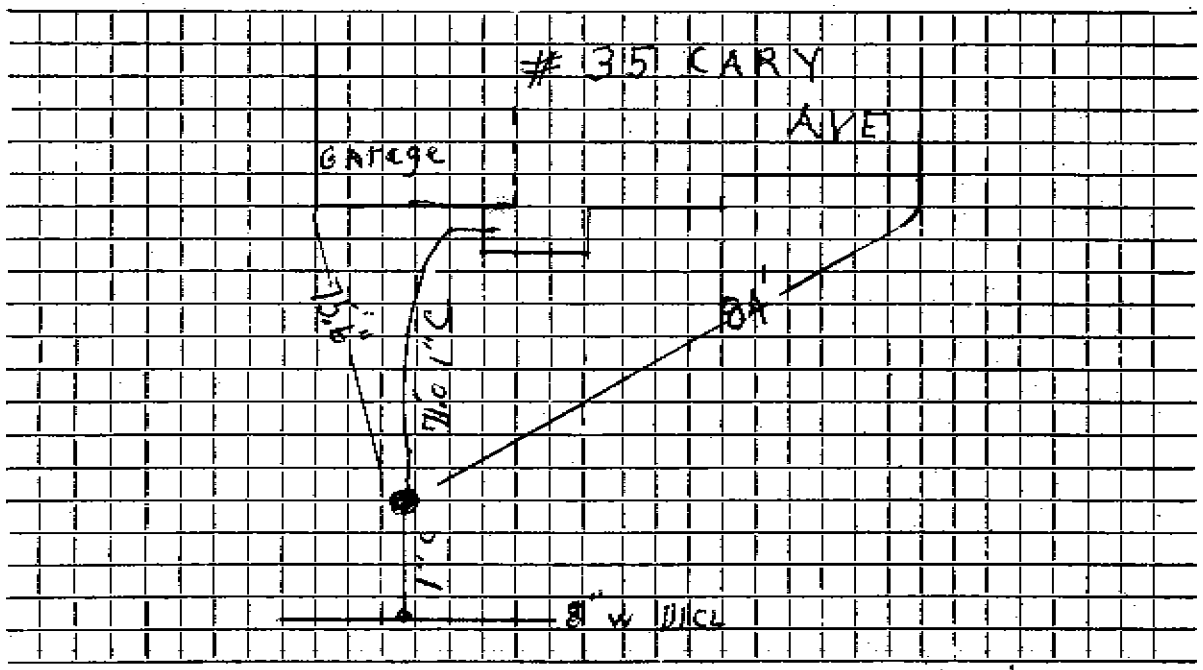

Connection made in ..... Street. Work completed 11/14/06 J. McLaughlin

Remarks: .....