WATER SERVICE RECORD

Name *Mr. DeAngelis* **Service No.**

Address *126 Cedar Street*

Location

~~**Repair**~~ **—Renewal—** ~~**New Service**~~ *Redmond #4124*

Date		Material	Amount	Total	Date		Amount
4/23/85	*23'*	*3/4" Copper tubing*					
		3/4" Ball Valve					
						OUTSIDE	
					4/23/85	*3/4" Copper tubing*	

DATE _____

TOWN OF LEXINGTON — BOARD OF PUBLIC WORKS

WATER DIVISION

Sketch of Service Here

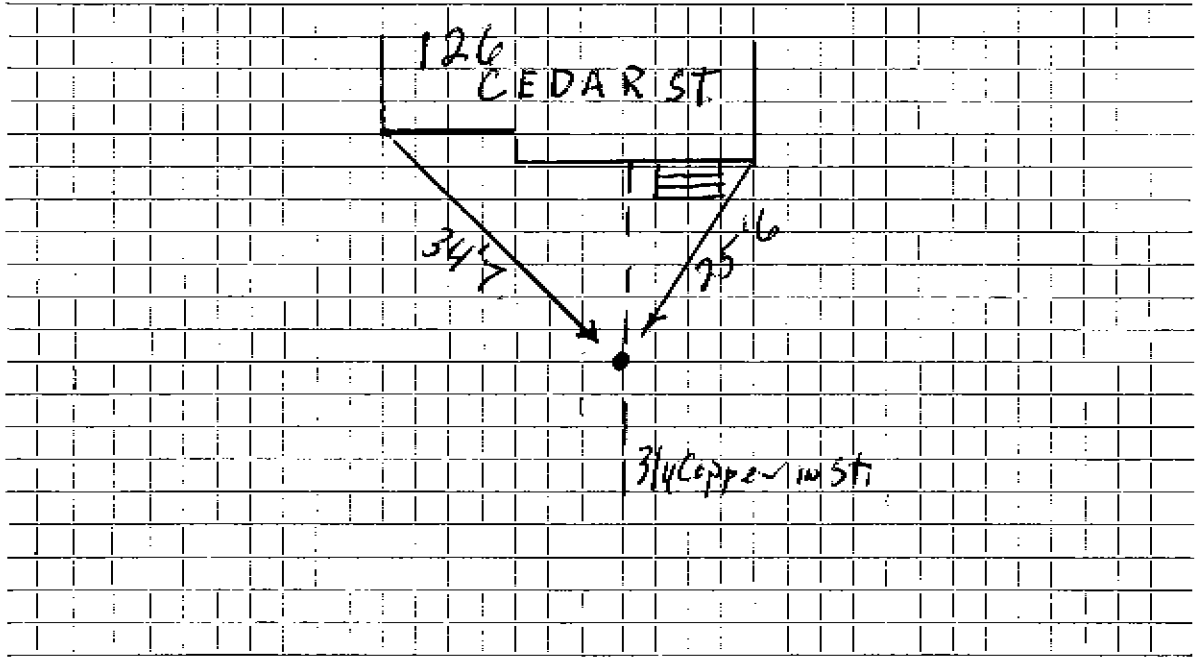

Connection made in ..... Street. Work completed .....

Remarks: .....

.....

.....