HP-10025

WATER SERVICE RECORD

Name **Service No.**

Address 20 Chadbourne Rd.

Location Lexington

~~Repair Renewal~~ **New Service**

Date	Material	Amount	Total	Date		Amount
					NON CHARGE	
				5/13/53	Labor	3 49
					20'-3/4" Copper Tubing @.34	6 80
					1-3/4" C. Corp-cock	4 33
					1-3/4" C x 3/4" C. Curb-cock	4 67
					1-Box & Rod	3 90
					1 Hr. Tracking	75
						23 94

DATE _____

TOWN OF LEXINGTON — BOARD OF PUBLIC WORKS

WATER DIVISION

Sketch of Service Here

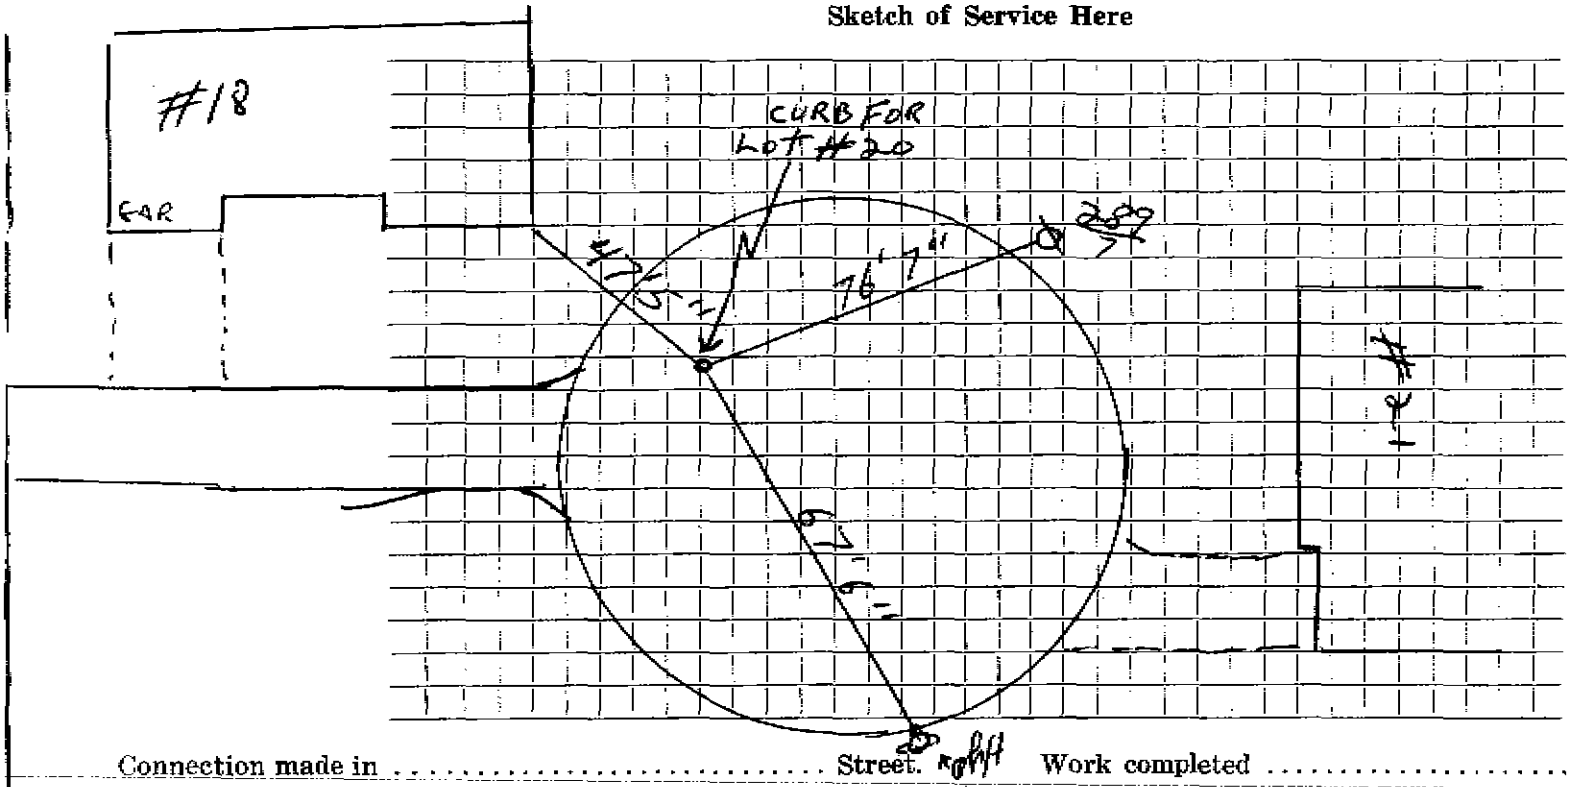

Connection made in ..... Street. Work completed .....

Remarks: .....

.....

.....