R.B.M.16015

WATER SERVICE RECORD

Name Leonard Colwell **Service No.** 10

Address 3 Chadbourne Road

Location

~~Repair~~—New Service Comm. 4-4-60

Date	Material	Amount	Total	Date		Amount
3-24-60	Labor	16 68		3-7-60	Deposit	$ 40 00
	10% O.H.	1 67	18 35	4-8-60	Bal	39 11
	83' 3/4" Copper tubing @ .42		34 86			79 11
	1 3/4" Cx½ IWH Stop&Waste		5 88			
	1 3/4" C3 Part Union		2 27		NON CHARGE	
	2½ Hr. Town Shovel @ 6.50		16 25		Labor	
	2 Hrs. Trucking @ .75		1 50	1	½ Straight tailpiece	50
			79 11	1	½ Offset tailpiece	50
						1 00

4-5-60 Bal Due $39.11

DATE _____

TOWN OF LEXINGTON — BOARD OF PUBLIC WORKS

WATER DIVISION

Sketch of Service Here

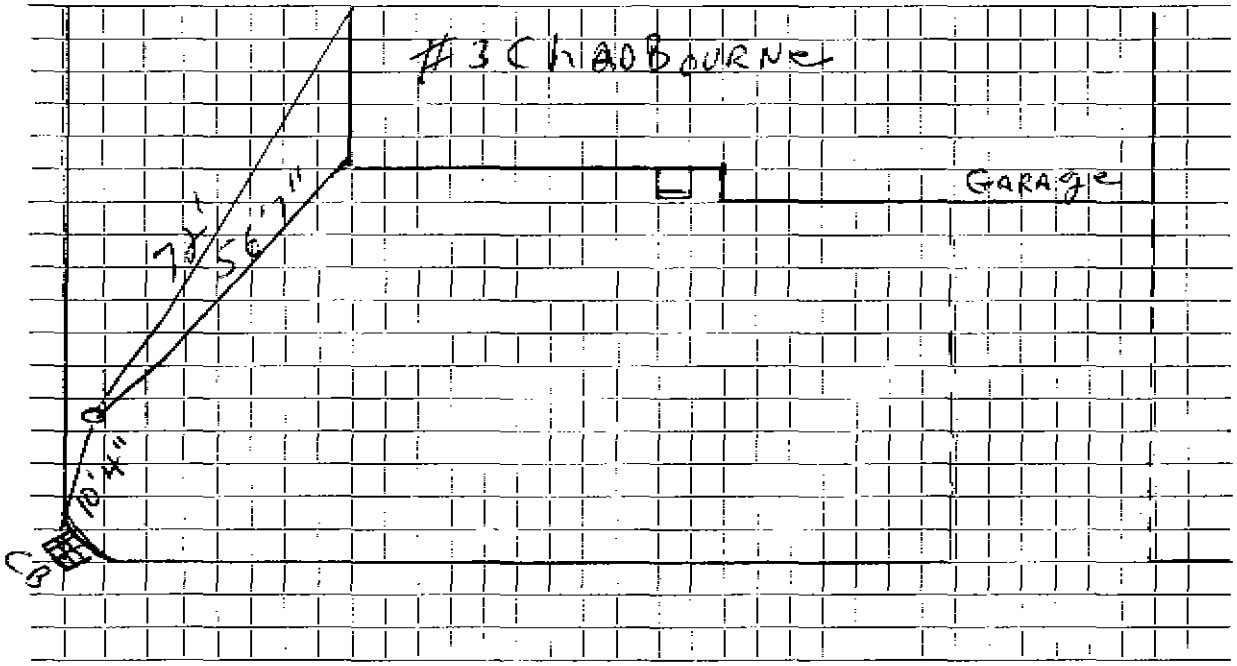

Connection made in ..... Street. Work completed .....

Remarks: .....

.....

.....

WATER SERVICE RECORD

Name RICK TESTA **Service No.**

Address 3 CHADBOURNE ROAD

Location

Repair—Renewal—New Service - PERMIT № 1098

Date		Material	Amount		Total		Date			Amount	
JUNE 5	1998	80' 1" COPPER									

DATE JUNE 5 1998

TOWN OF LEXINGTON — BOARD OF PUBLIC WORKS

WATER DIVISION

Sketch of Service Here

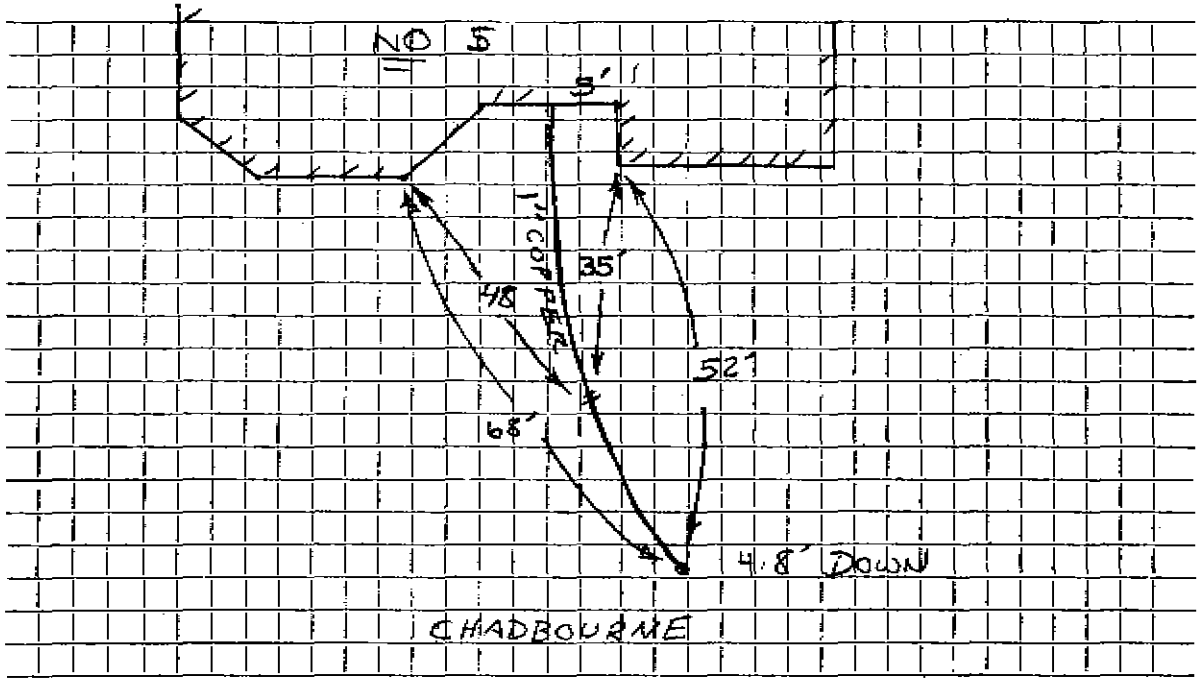

Connection made in CHADBOURNE RD Street. Work completed MARCONE BROS

Remarks:

FIELD BOOK 99-1 T&M