HP - 576

WATER SERVICE RECORD

Name **Service No.**

Address 7 Childs Road

Location

~~Repair~~ ~~Renewal~~ **New Service** Service into curb only

Date	Material	Amount	Total	Date		Amount	
					Non Charge		
				9/16/55	Labor	1	85
					91'-3/4" Copper tubing @.56	50	96
					1-3/4" C Corp Cock	4	33
					1-3/4" C Curb Cock	4	67
					1 Box & Rod	3	90
					1 hr. trucking @.75		75
						66	46

DATE _____

TOWN OF LEXINGTON — BOARD OF PUBLIC WORKS

WATER DIVISION

Sketch of Service Here

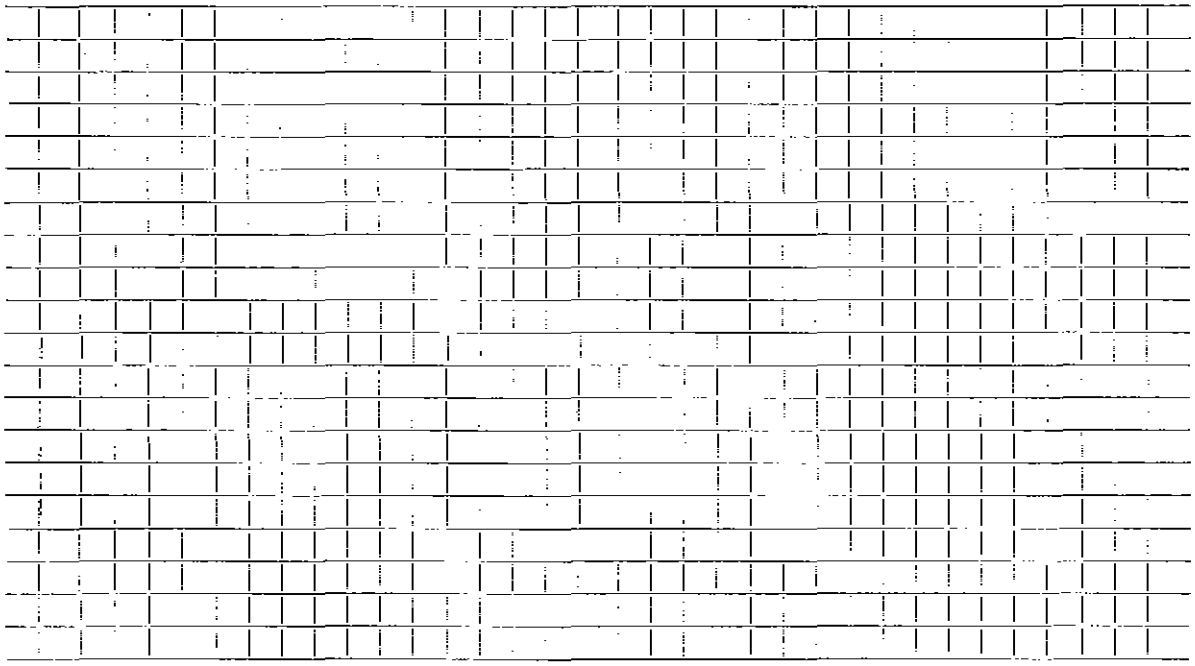

Connection made in ..... Street. Work completed .....

Remarks: .....

.....

.....