WATER SERVICE RECORD

Name | **Service No.**

Address 17 Cider Mill Lane Johnson's Farm

Location Lot #10

Repair—Renewal—New Service

Date		Material	Amount	Total	Date			Amount
9/23/03	23.5	1" Copper			Jul 4 03	17'	1" Copper 1" Corp 1" Curb Buffalo Box	

DATE July 2003

TOWN OF LEXINGTON — BOARD OF PUBLIC WORKS

WATER DIVISION

Sketch of Service Here

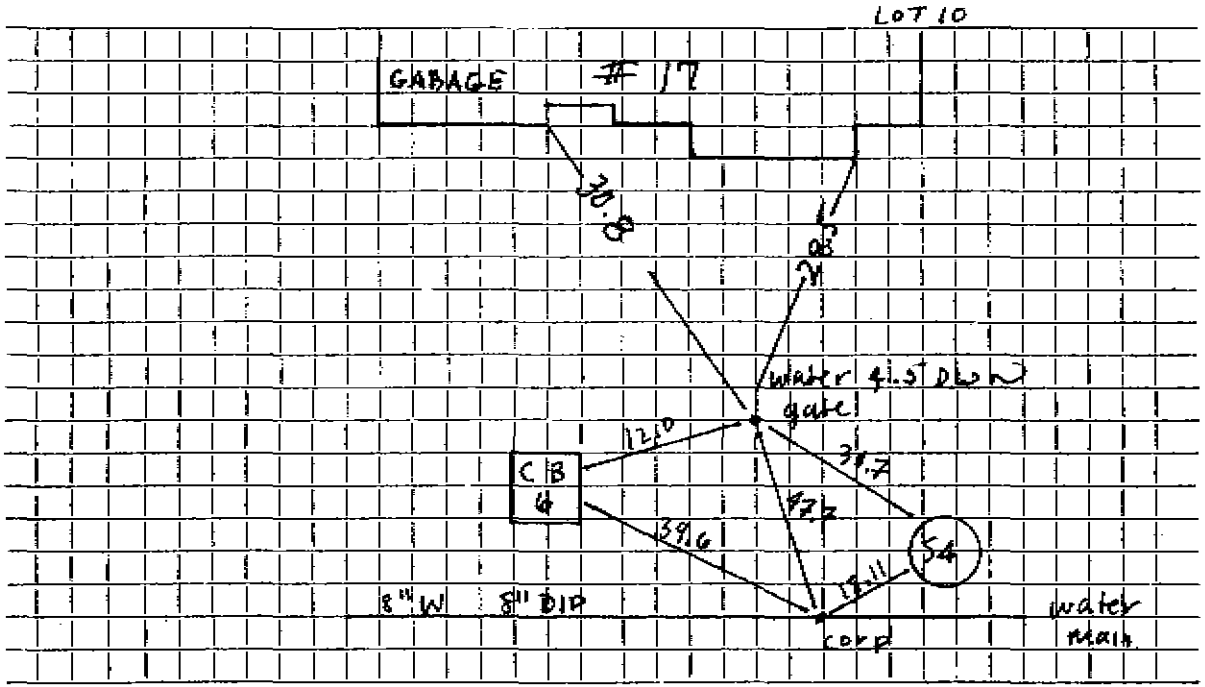

Connection made in ..... Street. Work completed 9/03

Remarks: .....

.....

.....