K.B.M.16010

WATER SERVICE RECORD

Name Busa Reality Trust **Service No.**

Address 24 Circle Road

Location Lot # 206-208

Repair—Renewal—New Service DeFlice Brothers # 404 1014

Date		Material	Amount		Total		Date			Amount	
1968	48.6'	3/4" Copper Tubing									

DATE _____

TOWN OF LEXINGTON — BOARD OF PUBLIC WORKS

WATER DIVISION

Sketch of Service Here

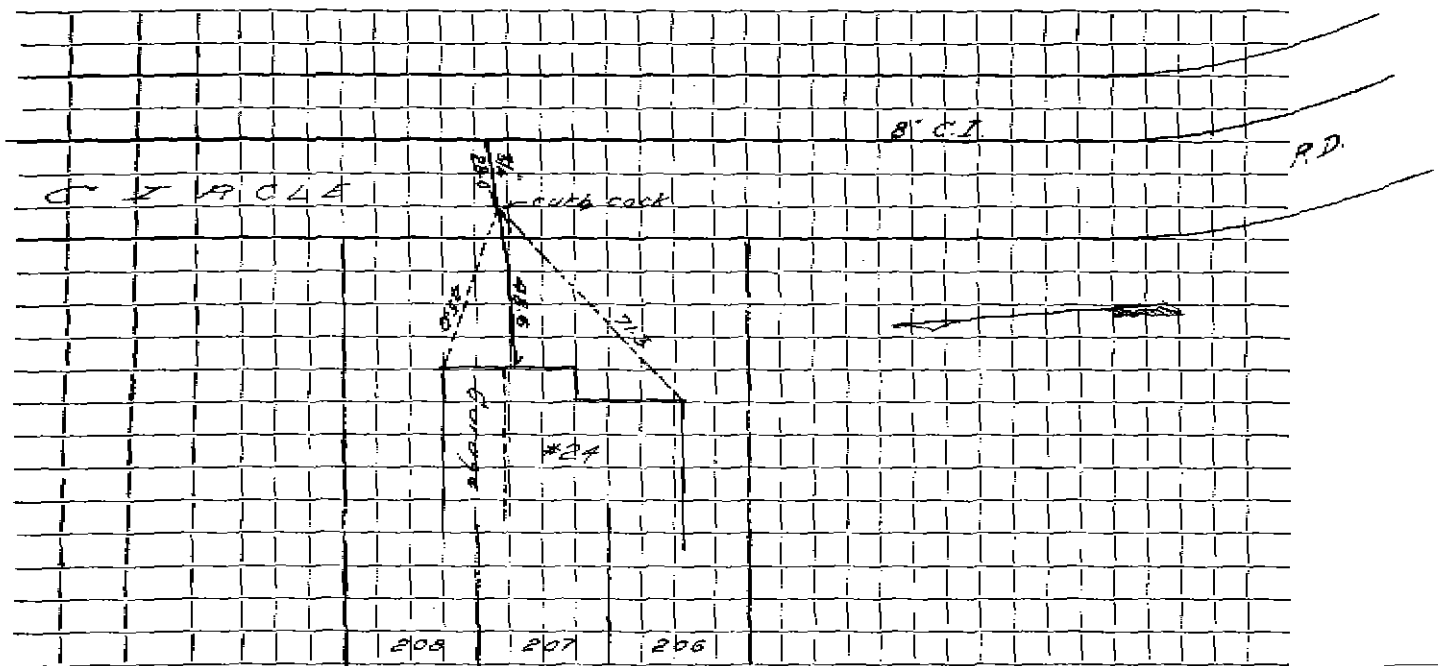

Connection made in . . . . . Street. Work completed . . . . . .

Remarks: . . . . . .

. . . . . .

. . . . . .