B.B.M.16010

WATER SERVICE RECORD

Name Busa Realty Trust **Service No.**

Address 4 Circle Road

Location

Repair—Renewal—New Service DeFlice #768

Date		Material	Amount	Total	Date		Amount
9-11-67	60'	3/4" Copper tubing					

DATE _____

TOWN OF LEXINGTON — BOARD OF PUBLIC WORKS

WATER DIVISION

Sketch of Service Here

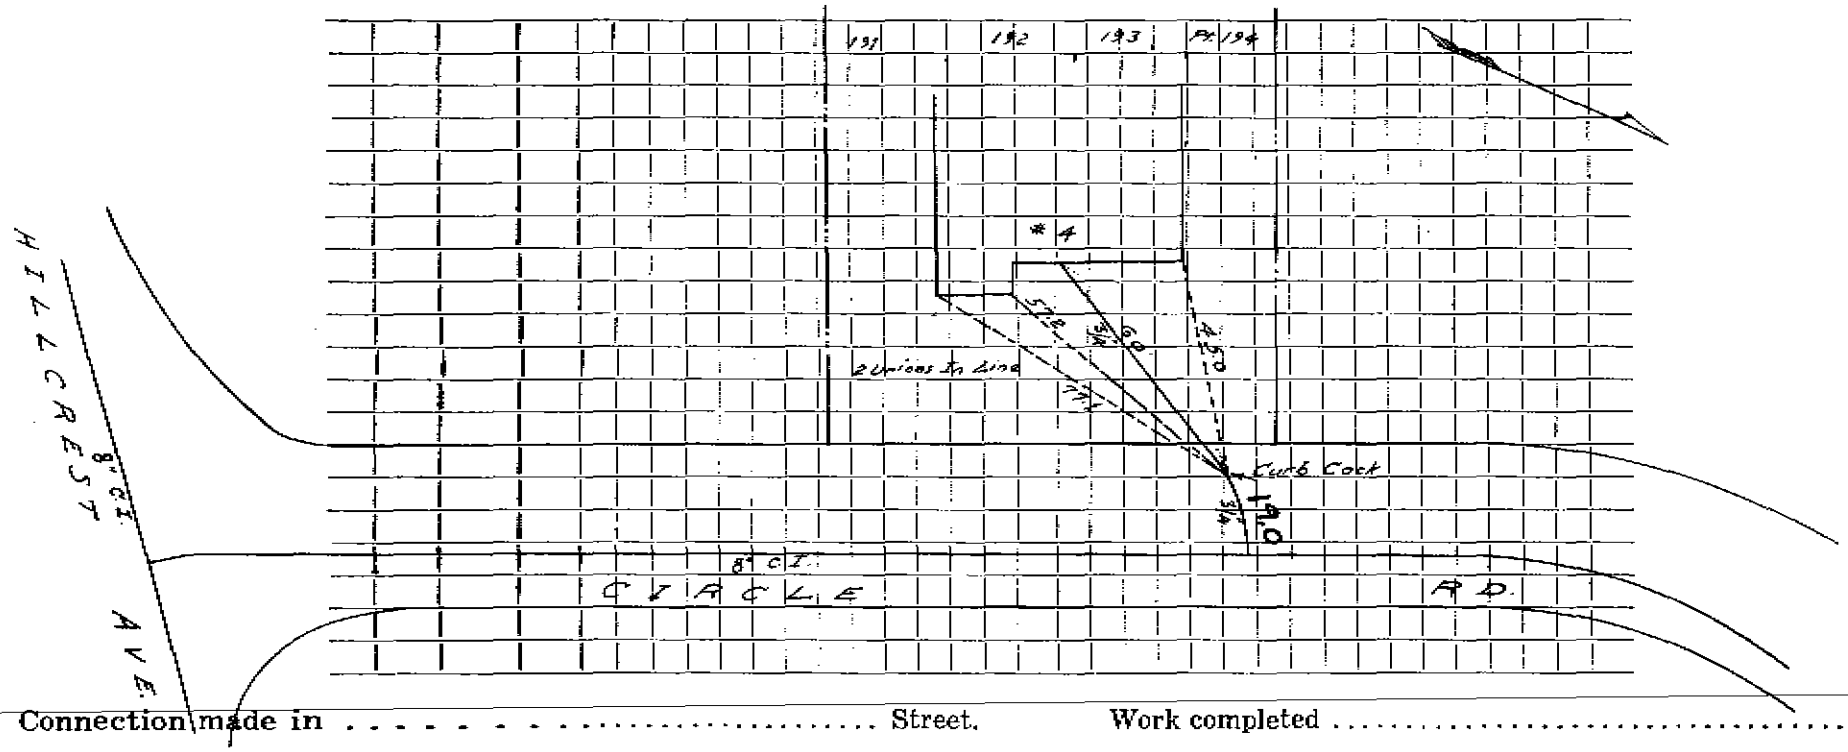

Connection made in . . . . . Street. Work completed . . . . . .

Remarks: . . . . . .

. . . . . .

. . . . . .