WATER SERVICE RECORD

Name Mrs. Molina **Service No.**

Address 8 CLEMATIS RD.

Location

Repair—Renewal—New Service McLaughlin #0053

Date	Material	Amount	Total	Date		Amount
5/17/90	58' LF 1" COPPER					
	1" COUPLING			10/26/87	1" CORP	
					1" CURB	
					BORA ROD	
					1" COPPER	

DATE _____

TOWN OF LEXINGTON — BOARD OF PUBLIC WORKS

WATER DIVISION

Sketch of Service Here

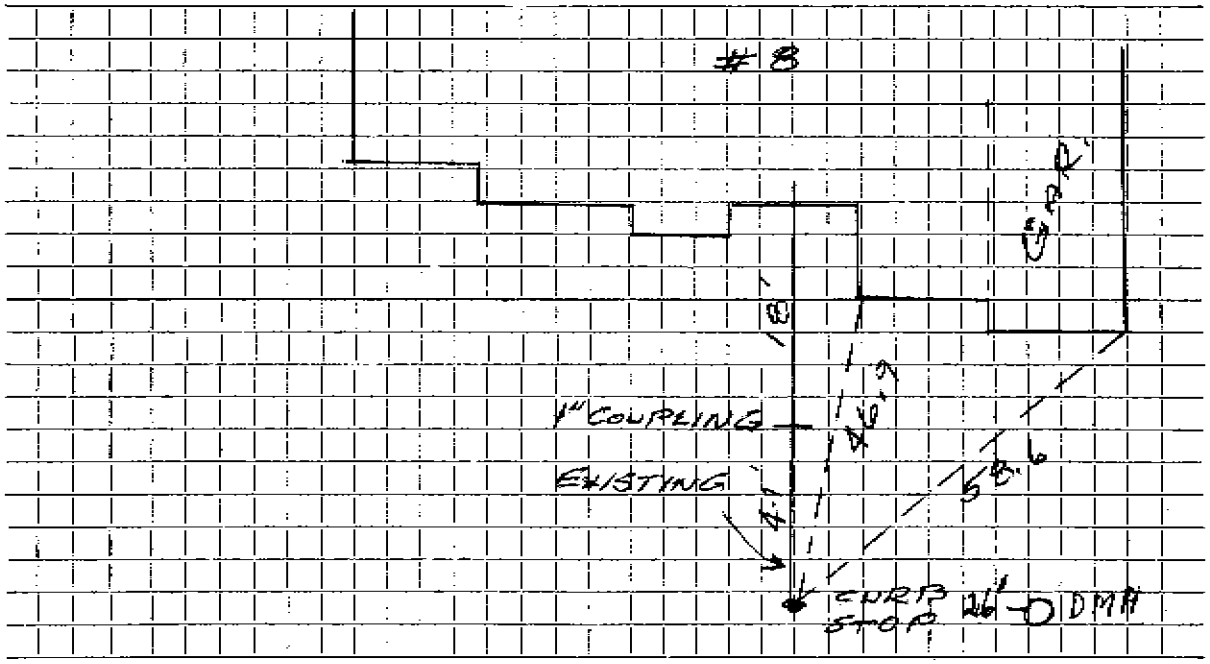

Connection made in ..... Street. Work completed .....

Remarks: CONNECT NEW SERV. TO EXIST. 1" COPPER .....