WATER SERVICE RECORD

Name | **Service No.**

Address 64 Cliffe Ave

Location Pg 20 Lot 159

Repair—Renewal—New Service

Date		Material	Amount		Total		Date		Amount	
3/24/11	50'	1" Copper						3/4 Copper		
		3/4 x 6 Long Nipple						3/4 Curb		
		3/4 x 1" Increaser						3/4 Corp		
		buffalo box								

DATE _____

TOWN OF LEXINGTON — BOARD OF PUBLIC WORKS

WATER DIVISION

Sketch of Service Here

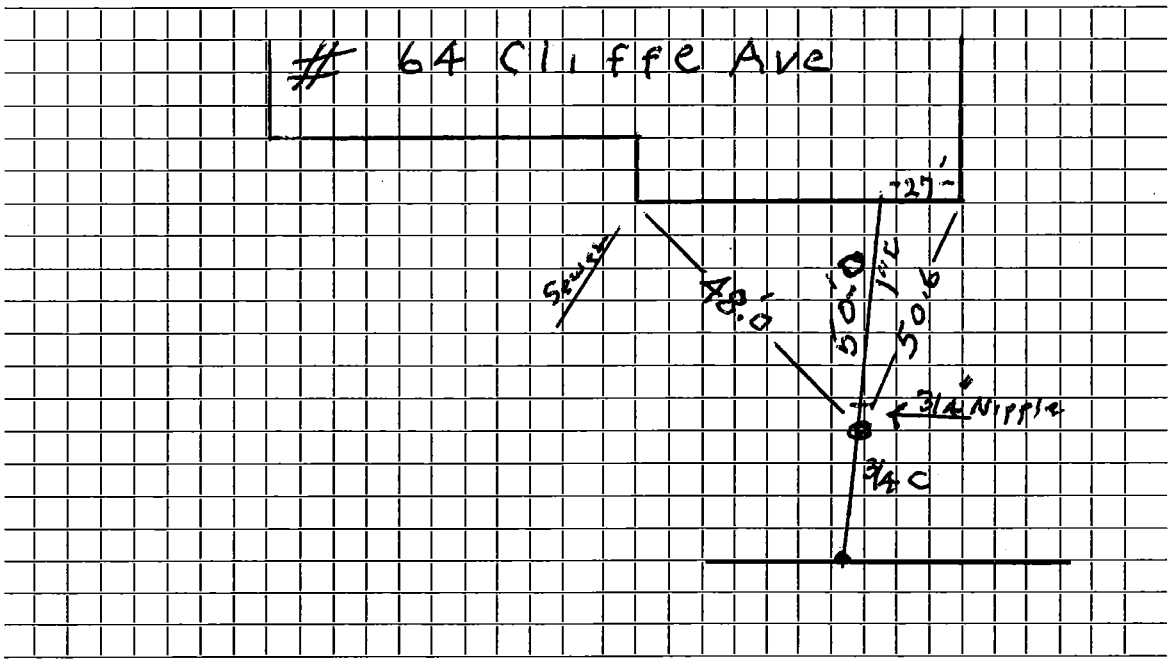

Connection made in Cliffe Ave Street. Work completed 3/24/11

Remarks: .....

.....

.....