R.B.M.16010

WATER SERVICE RECORD

Name Tocco Brothers **Service No.**

Address 1 Cbach Road

Location Lot #9

Repair—Renewal—New Service Ferrari Plumbing Permit #A341

Date		Material	Amount	Total	Date			Amount
6/21/66	60'	3/4" Copper tubing			9/29/65			
						18'	3/4 COPPER	
						1	3/4 CorP	
						1	3/4 Curb	
							Box & Rod	

DATE: _____

TOWN OF LEXINGTON — BOARD OF PUBLIC WORKS

WATER DIVISION

Sketch of Service Here

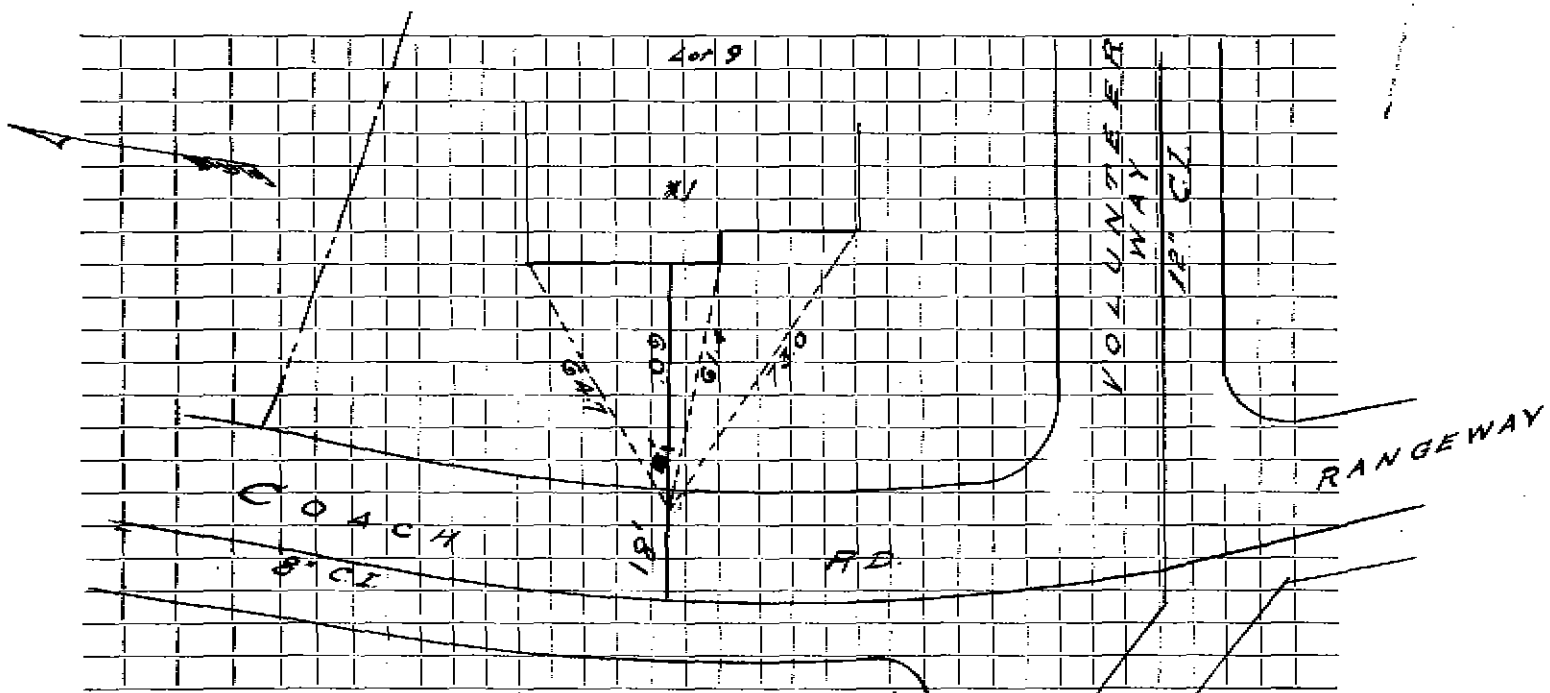

Connection made in ..... Street. Work completed .....

Remarks: .....

.....

.....