H.B.M.15010

WATER SERVICE RECORD

Name **Service No.**

Address 2 Coach Road

Location Lot #23

~~[illegible]~~—**New Service** Dave Eagle Permit #A247

Date		Material	Amount		Total		Date			Amount	
4-25-66	28'	3/4" Copper tubing									
3/16/77	90'	1" copper tubing									

DATE _____

TOWN OF LEXINGTON — BOARD OF PUBLIC WORKS

WATER DIVISION

Sketch of Service Here

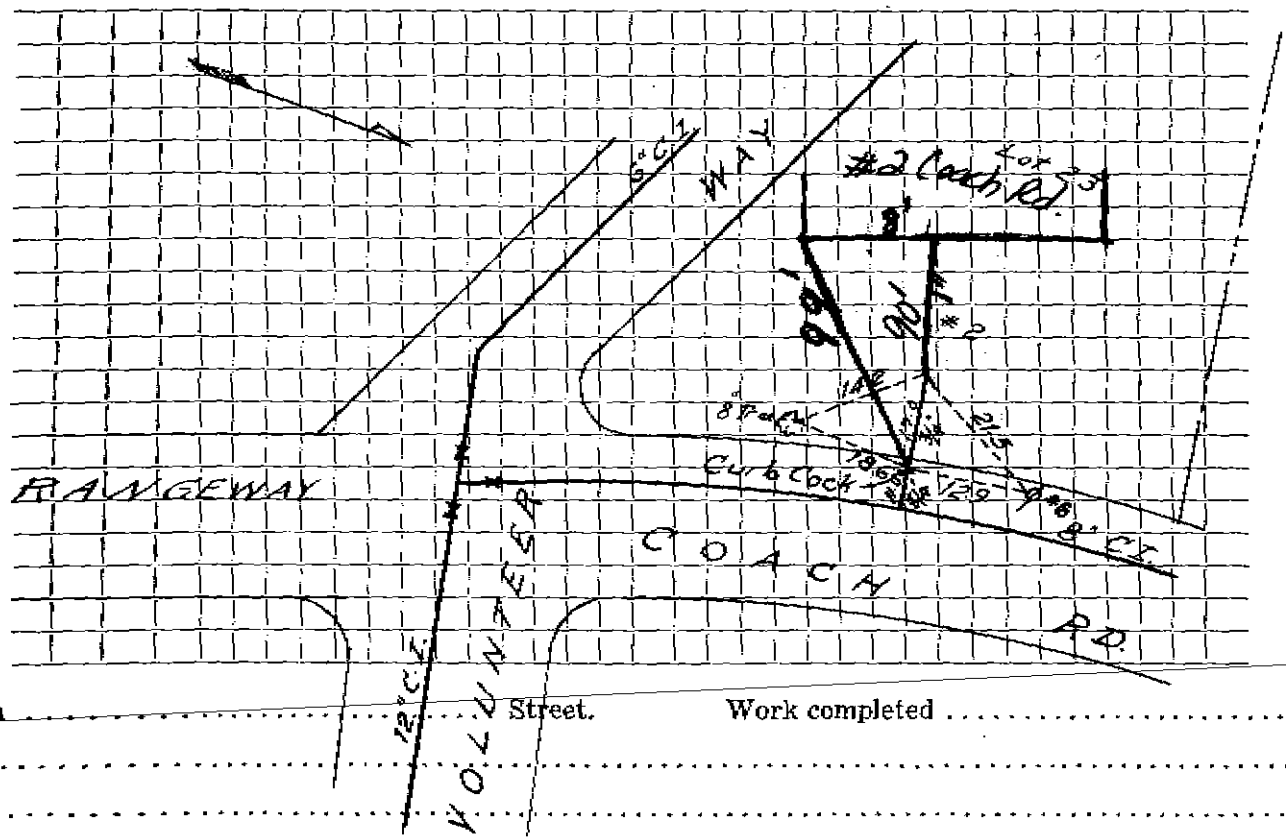

Connection made in ..... Street. Work completed .....

Remarks: .....

.....

.....