N.B.W.16010

WATER SERVICE RECORD

2333
Service No.

Name Stone Realty Trust

Address 6 Coach Road

Location Sta.4+25L Lot #12A

~~**Repair, Renewal**~~ **New Service** Dave Eagle - Permit #490 DeFlice Brothers # A 474

Date		Material	Amount		Total		Date			Amount	
9-29-65	24'	3/4" Copper tubing									
12/8/66		74' 3/4" Copper									

DATE_____

TOWN OF LEXINGTON — BOARD OF PUBLIC WORKS

WATER DIVISION

Sketch of Service Here

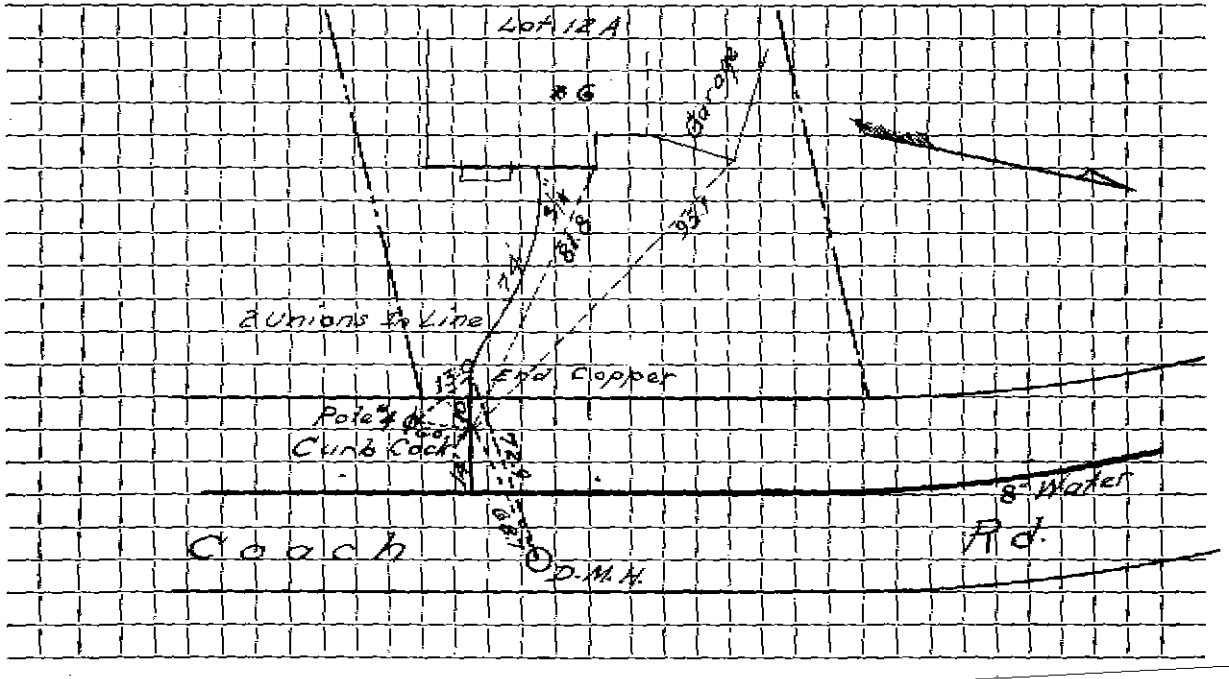

Connection made in ..... Street. Work completed .....

Remarks: .....

.....

.....