H.B.M.16010

WATER SERVICE RECORD

Name Stone Realty Trust - Robert Townsend **Service No.** ~~# 6879~~ # 8791

Address 9 Coach Road # 407

Location Sta.7+51R Lot #6

~~Repair Renewal~~—**New Service**

Date		Material	Amount	Total	Date		Amount
9-27-65	59'	3/4" Copper tubing - curb to house					
		DeFlice Bros.					
9-27-65	22'	3/4" Copper tubing - main to curb					
		Dave Eagle					

DATE _____

TOWN OF LEXINGTON — BOARD OF PUBLIC WORKS

WATER DIVISION

Sketch of Service Here

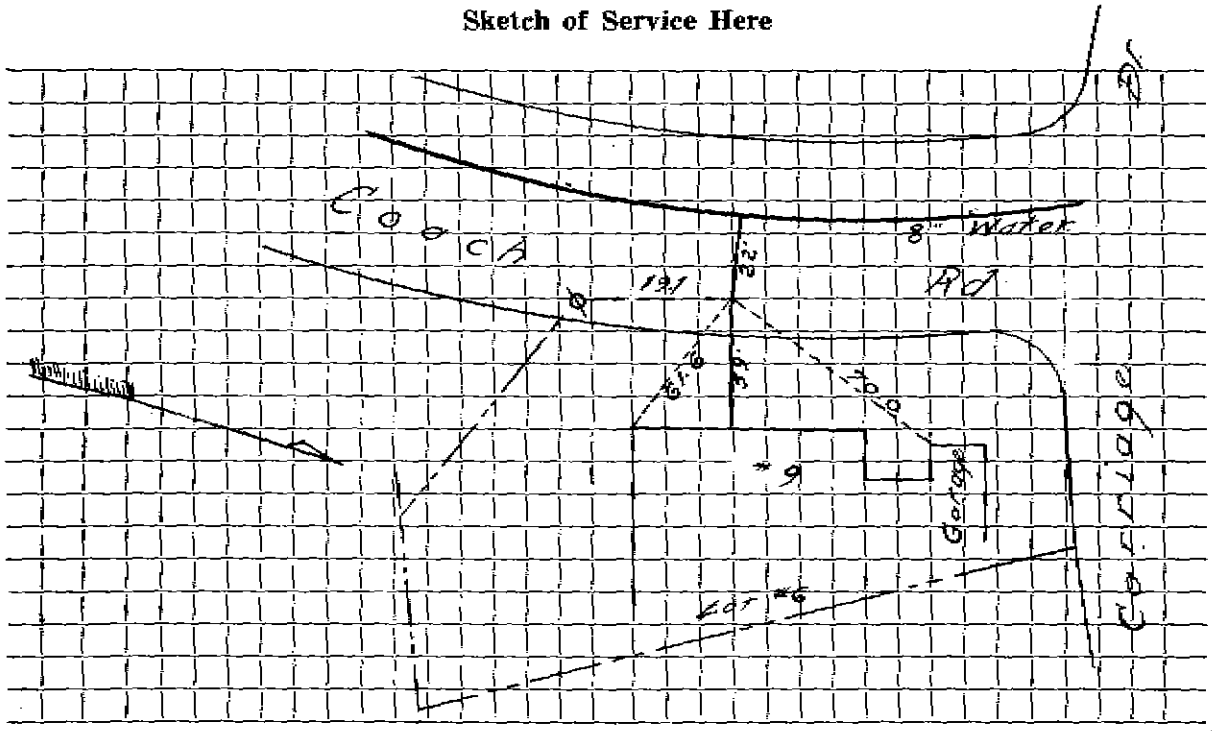

Connection made in ..... Street. Work completed .....

Remarks: .....

.....

.....