WATER SERVICE RECORD

Name | **Service No.**

Address 136 Concord Ave

Location Lot 40 PG 4

Repair—Renewal—New Service Cont. Fare 11 - D. P. Eng.

Date	Material	Amount	Total	Date		Amount
11/2011	1" Copper			1982	22' 3/4 Copper	
	1" Curb				3/4 Corp	
	Buffalo box				3/4 curb	
	3/4 x 1" Increaser				Brass rod	

DATE _____

TOWN OF LEXINGTON — BOARD OF PUBLIC WORKS

WATER DIVISION

Sketch of Service Here

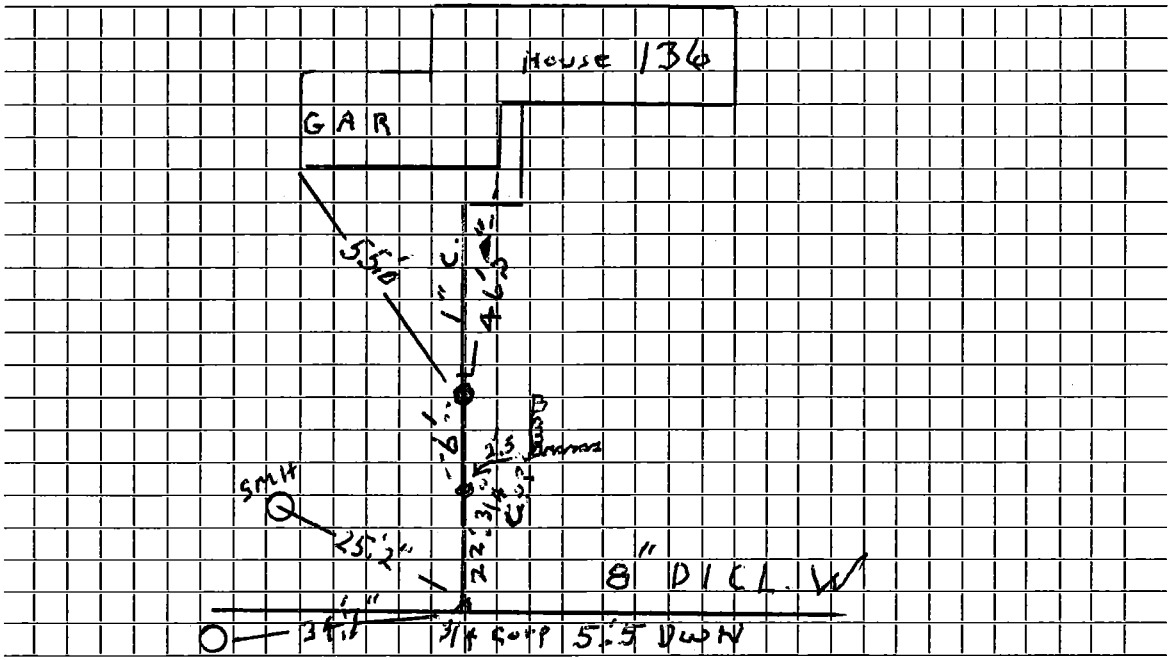

Connection made in ..... Street. Work completed 11/20/11

Remarks: .....

.....

.....