WATER SERVICE RECORD

Name **Service No.**

Address

Location 181 CONCORD AVE

Repair — **Renewal** — **New Service** CANNIZZO UPGRADE

Date		Material	Amount	Total	Date			Amount
					1982	11'	3/4 C	
4/5/00	64'	1" Copper				1	3/4 CORP	
	1	1" UNION				1	3/4 Curb	
	1	1"F X 1" Comp FOR 3/4 Flare Curb						
	1	Buffalo Box						

DATE _____

TOWN OF LEXINGTON — BOARD OF PUBLIC WORKS

WATER DIVISION

Sketch of Service Here

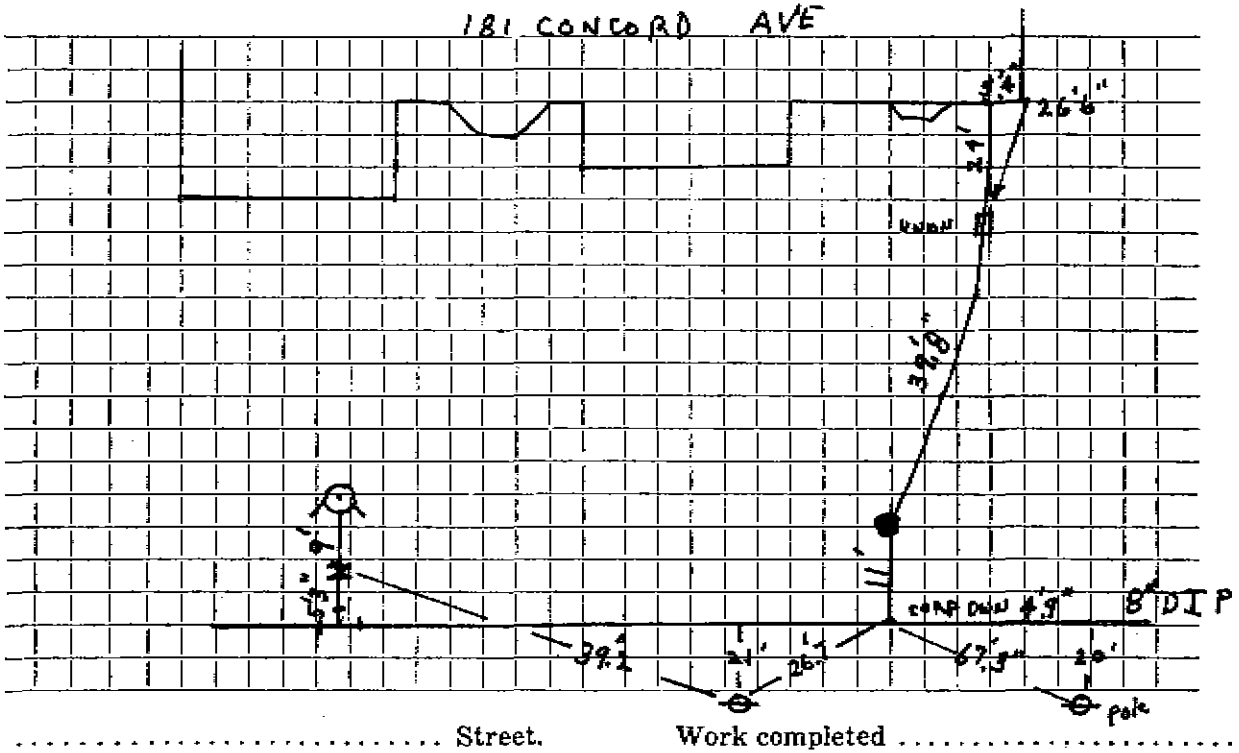

Connection made in ..... Street. Work completed .....

Remarks: .....

.....

.....