WATER SERVICE RECORD

Name HOMES REALTY

Service No.

Address #365-367 CONCORD AVENUE

Location

Repair—Renewal—New Service

PERMIT NO. 0298 McLaughlin

Date		Material	Amount		Total		Date			Amount	
1993	20'	1" Copper									

DATE 8 NOVEMBER 1993

TOWN OF LEXINGTON — BOARD OF PUBLIC WORKS

WATER DIVISION

Sketch of Service Here

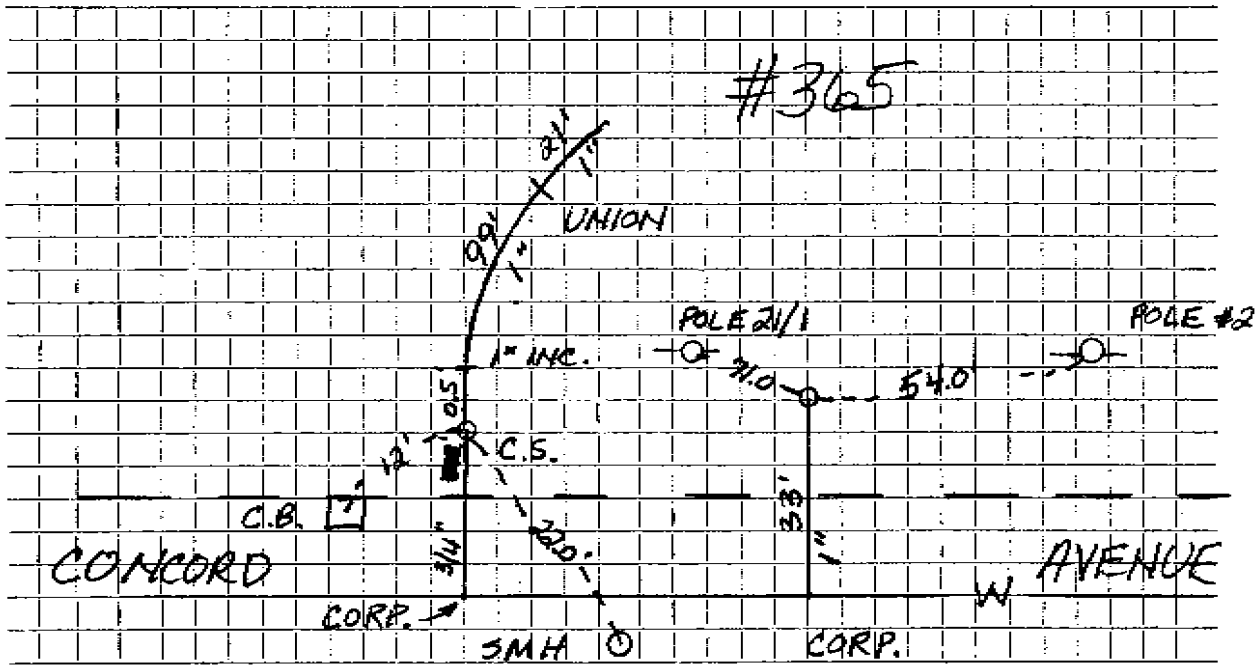

Connection made in CONCORD AVENUE Street. Work completed HOMES REALTY

Remarks:

BOOK 96A J.W.