E.B.K.16010

WATER SERVICE RECORD

2263

Name Newton Builders, Inc. **Service No.** 111

Address 456 Concord Avenue

Location

~~Repair~~ ~~Renewal~~ **New Service**

Conn 9-25-61

Date	Material	Amount	Total
8-18-61	Labor	69.06	
	10% O.H.	6.91	75.97
	130' 3/4" Copper Tubing @.42		54.60
	1 3/4" C x ½ I.W.H. Stop & Waste		6.17
	2 3/4" c 3 part unions @2.41		4.82
	3 Hrs. Town Shovel @6.50		19.50
	3 Hrs. Trucking @3.00		9.00
	1 Hr. Trailer @3.00		**** 3.00
			173.06

Date		Amount
8-9-61	Deposit	150 00
12-19-61	Paid	23 06
		173 06
	NON CHARGE	
8-18-61	Labor	6.38
	12' 3/4" Copper Tubing @.42	5.04
1	3/4" C Corp Cock	4.91
1	3/4" C Curb Cock	6.28
1	Box & Rod	4.90
1½	Straight tailpiece	.50
1½	Offset tailpiece	.50
		28.51

DATE _____

TOWN OF LEXINGTON — BOARD OF PUBLIC WORKS

WATER DIVISION

Sketch of Service Here

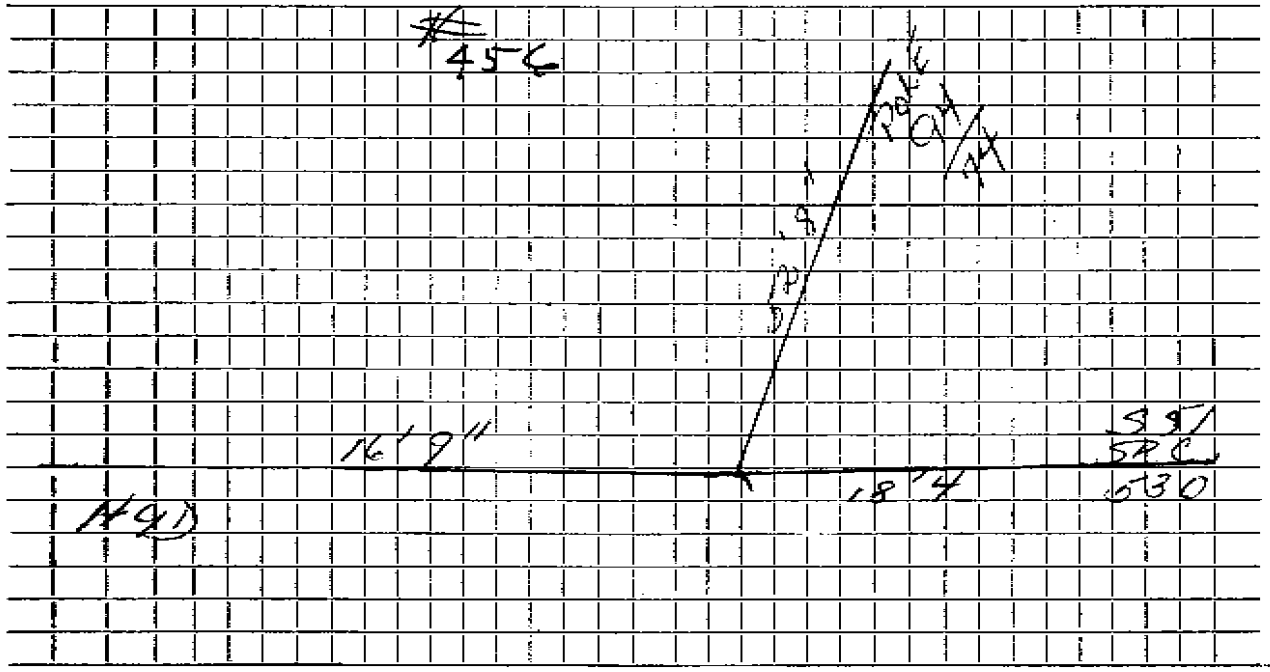

Connection made in ..... Street. Work completed .....

Remarks: .....

.....

.....