B.B.M.16010

WATER SERVICE RECORD

#1785

Name R.K. Schmidt **Service No.**

Address 15 Conestoga Road

Location Lot #8 ~~Sibley # 1960~~

Repair—Renewal—New Service Lucente #931

Date		Material	Amount		Total		Date			Amount	
12/1/67	48'	3/4" Copper tubing									
12/8/71	49'	3/4" Copper tubing									

DATE _____

TOWN OF LEXINGTON — BOARD OF PUBLIC WORKS

WATER DIVISION

Sketch of Service Here

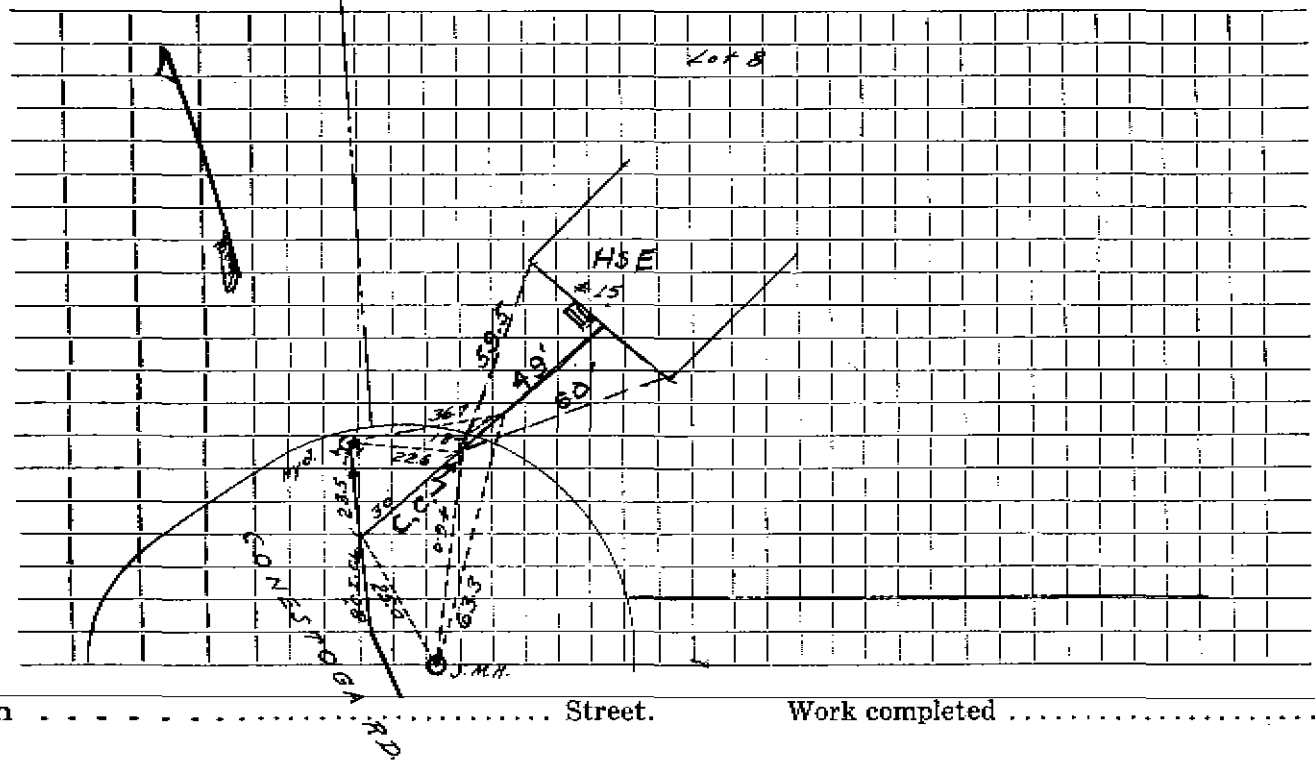

Connection made in . . . . . Street. Work completed . . . . . .

Remarks: . . . . . .

. . . . . .

. . . . . .