B.S.M.16010

WATER SERVICE RECORD

Name *Homes Realty* **Service No.**

Address 3 Conestoga Road

Location Lot #13

Repair—Renewal—New Service Lucente #926 *McLaughlin #0220*

Date		Material	Amount	Total	Date		Amount
32/4/67	36'	3/4 Copper tubing					
12/21/92	*48'*	*3/4" Copper tubing*					

DATE _____

TOWN OF LEXINGTON — BOARD OF PUBLIC WORKS

WATER DIVISION

Sketch of Service Here

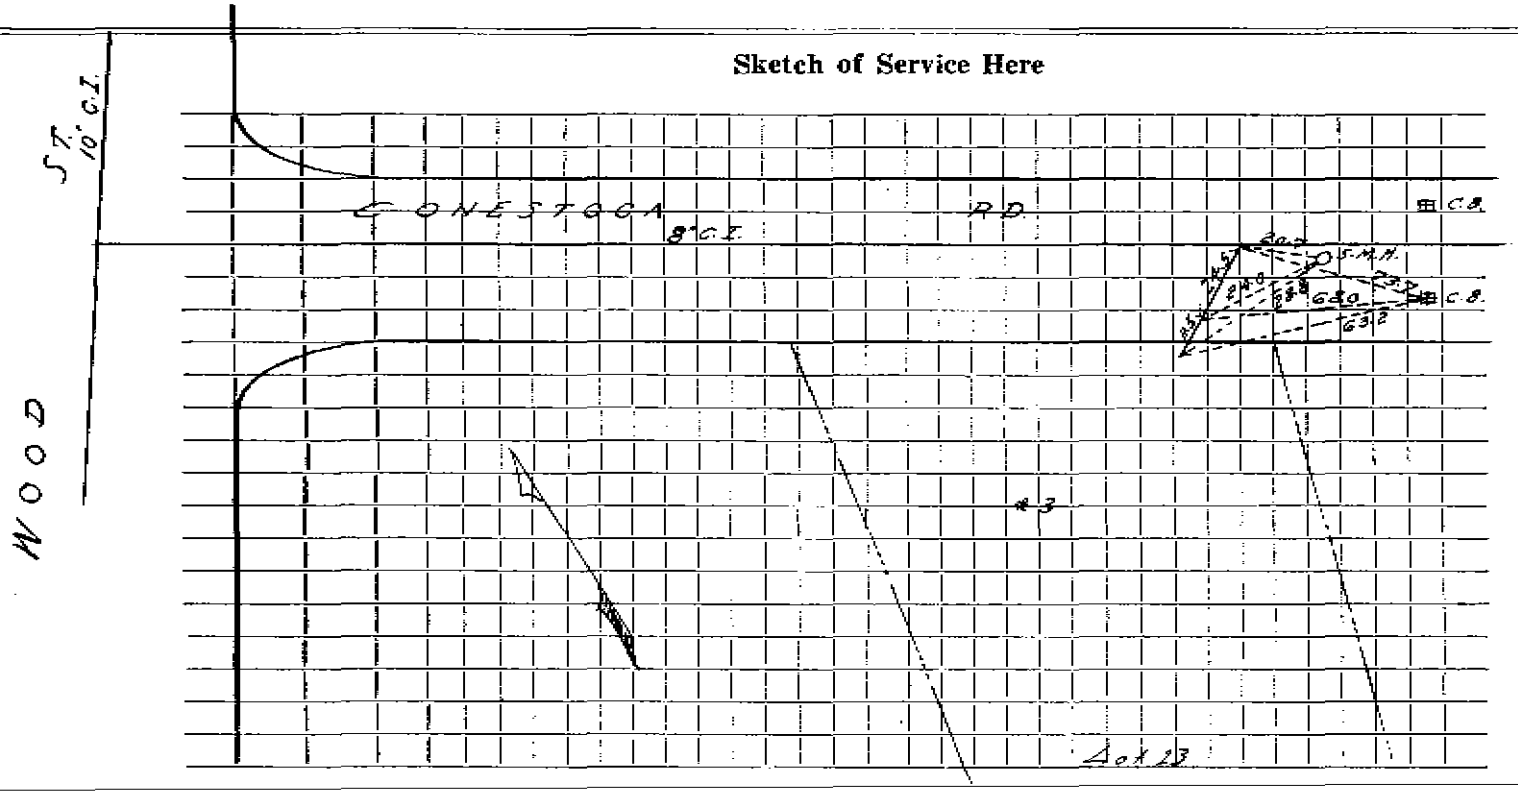

Connection made in . . . . . Street. Work completed . . . . . .

Remarks: . . . . . .

. . . . . .

. . . . . .