S.B.R.16020

#4783

WATER SERVICE RECORD

Name R. K. Schmidt **Service No.**

Address 4 Conestoga Road

Location Lot #4 Sibley # 1956

Repair—Renewal—New Service Lucente #936

Date	Material	Amount	Total	Date		Amount
12/4/67	13.5 3/4" Copper tubing					
12/21/71	75' 3/4" Copper tubing					

DATE_____

TOWN OF LEXINGTON — BOARD OF PUBLIC WORKS

WATER DIVISION

Sketch of Service Here

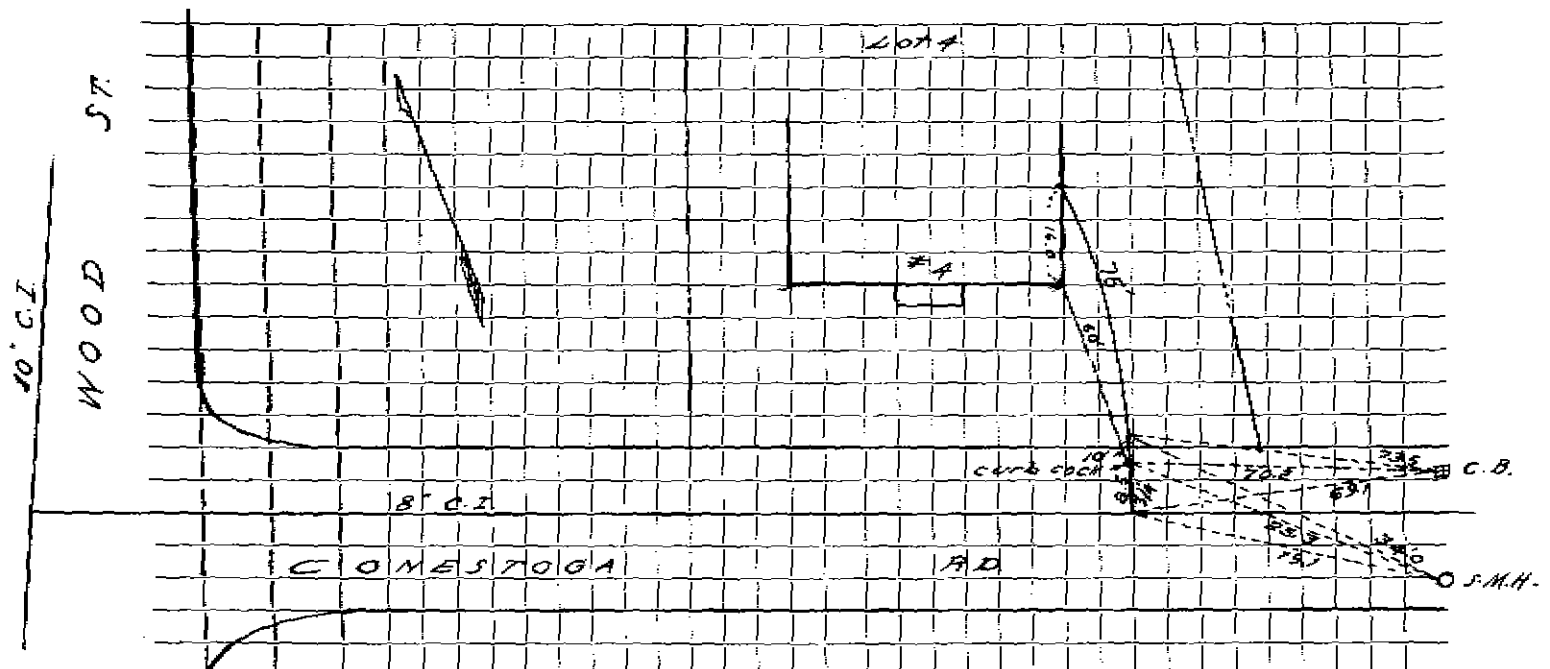

Connection made in ..... Street. Work completed .....

Remarks: .....

.....

.....