S.S.S.16010

# WATER SERVICE RECORD

**Name** E. E. Outhet **Service No.** #4562

**Address** 6 Conestoga Road

**Location** Lot #5 Sta 3+64

**Repair—Renewal—New Service** DeFlice #1293
Lucente #935

| Date | | Material | Amount | Total | Date | | Amount |
|---|---|---|---|---|---|---|---|
| 12/4/67 | 21' | 3/4 Copper tubing | | | | | |
| 4-2-69 | 65' | 3/4" Copper tubing | | | | | |

DATE_____

# TOWN OF LEXINGTON — BOARD OF PUBLIC WORKS

## WATER DIVISION

**Sketch of Service Here**

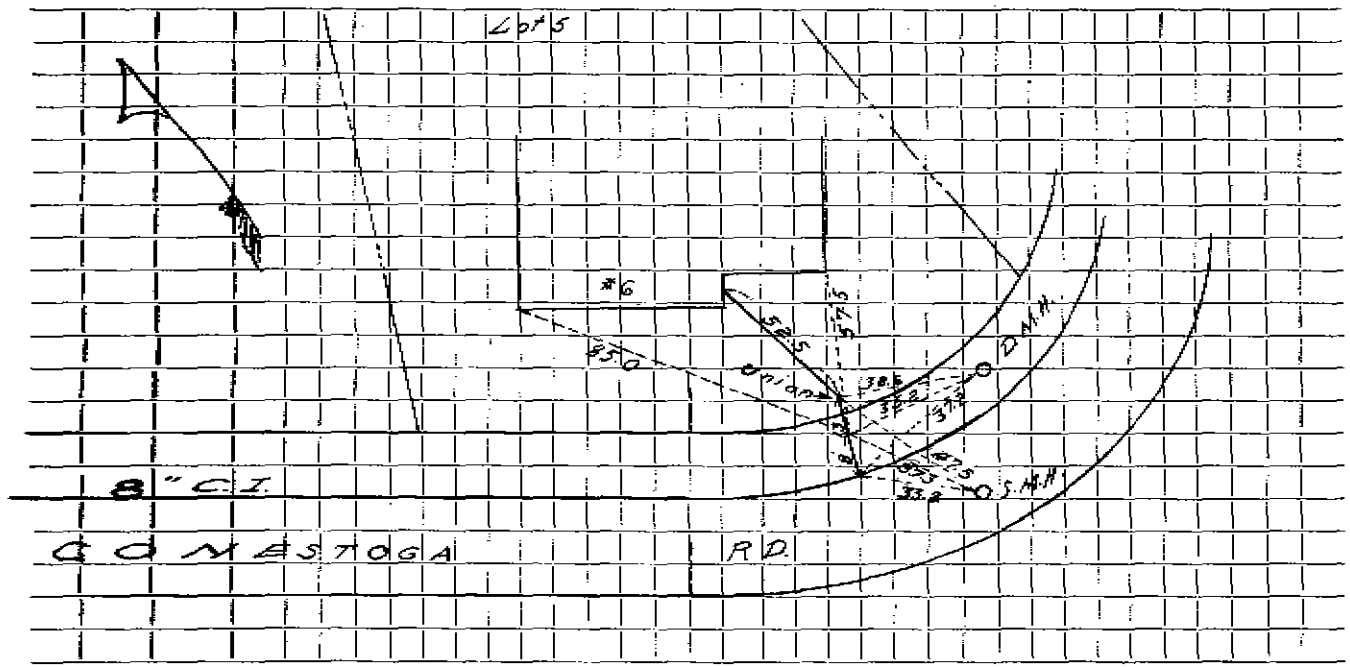


Connection made in ..... Street. Work completed .....

Remarks: .....

.....

.....