H.B.M.16010

#2008

WATER SERVICE RECORD

Name DeFlice Bros. **Service No.** #6553

Address 7 Conestoga Road

Location Lot #11

Repair—Renewal—New Service DeFlice #1280 Lucente #928

Date		Material	Amount	Total	Date		Amount
12/4/67	35'	3/4" Copper tubing					
12-17-68	47'	3/4" Copper tubing					

DATE _____

TOWN OF LEXINGTON — BOARD OF PUBLIC WORKS

WATER DIVISION

Sketch of Service Here

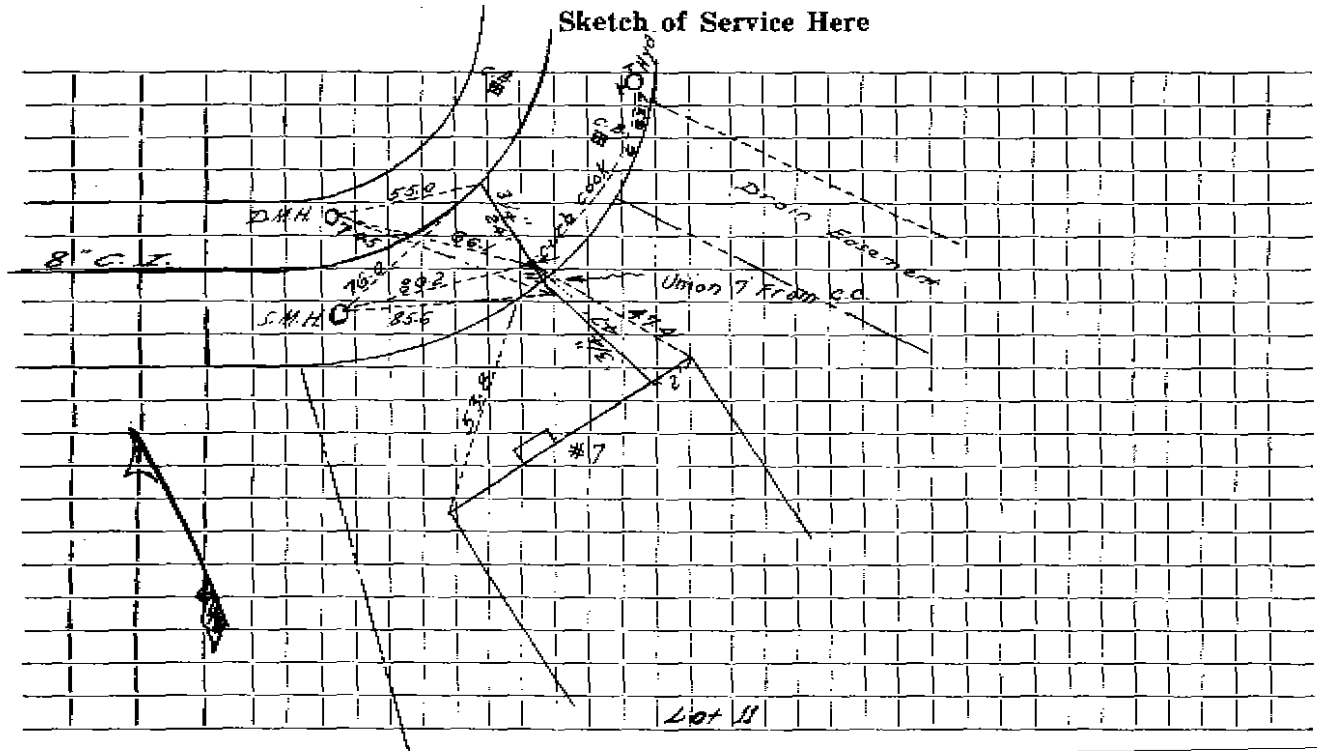

Connection made in . . . . . Street. Work completed . . . . . .

Remarks: . . . . . .

. . . . . .

. . . . . .