WATER SERVICE RECORD

Name **Service No.**

Address

Location CONNECTION @ MASS. AVE. & INDEPENDENCE

Repair—Renewal—New Service

Date		Material	Amount		Total		Date			Amount	
9-27-88		12"×8" TEE									
		12" GATE									
		8" GATE									
		2-12" SLEEVES									
		15 LF 12" CLDI									
		2 LF 8" CLDI									

DATE _____

TOWN OF LEXINGTON — BOARD OF PUBLIC WORKS

WATER DIVISION

Sketch of Service Here

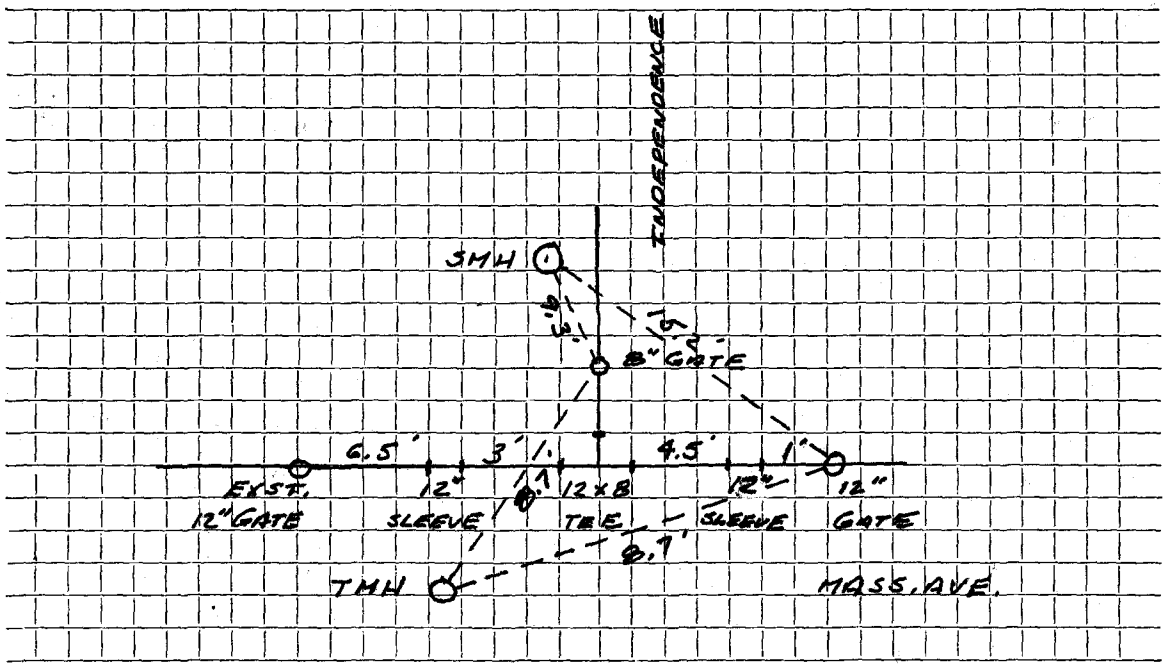

Connection made in MASS. AVE. ..... Street. Work completed .....

Remarks: .....

.....

.....