WATER SERVICE RECORD

Name **Service No.**

Address 20 Cottage Street

Location

Repair—Renewal—New Service

Date	Material	Amount	Total	Date			Amount
	1" Copper Valve				17'	1" Copper 1" Corp 1" Curb Box & Rod	

DATE _____

TOWN OF LEXINGTON — BOARD OF PUBLIC WORKS

WATER DIVISION

Sketch of Service Here

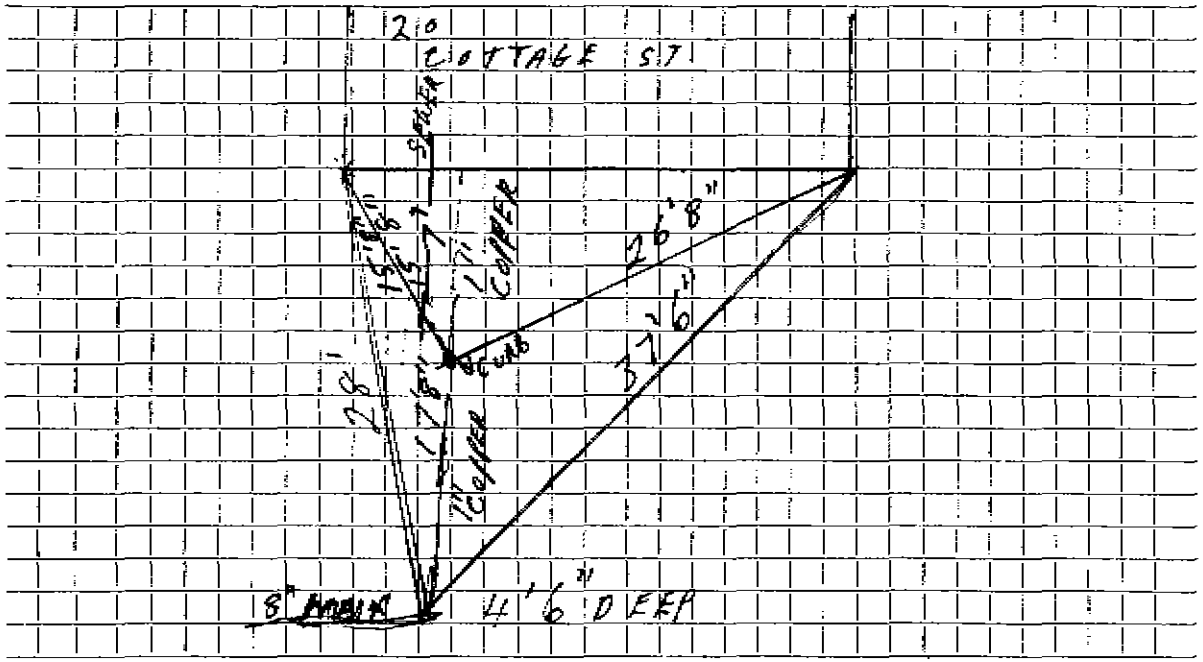

Connection made in ..... Street. Work completed .....

Remarks: .....

.....

.....