S.B.N.16010

#4246

WATER SERVICE RECORD

Name ——

Service No.

Address 10 Crescent Hill Avenue

Location

Repair—~~Renewal—New Service~~

Date	Material	Amount	Total	Date			Amount	
						NON CHARGE		
				8/5/63		Labor	93	15
					24'	3/4" Copper tubing @.42	10	08
					1	Curb Cock	6	28
					1	Adapter	1	62
						24x3 Patch	24	00
					3	hrs. Town Shovel @ 6.50	19	50
					2	hrs. Trucking @ 3.00	6	00
							160	63

DATE _____

TOWN OF LEXINGTON — BOARD OF PUBLIC WORKS

WATER DIVISION

Sketch of Service Here

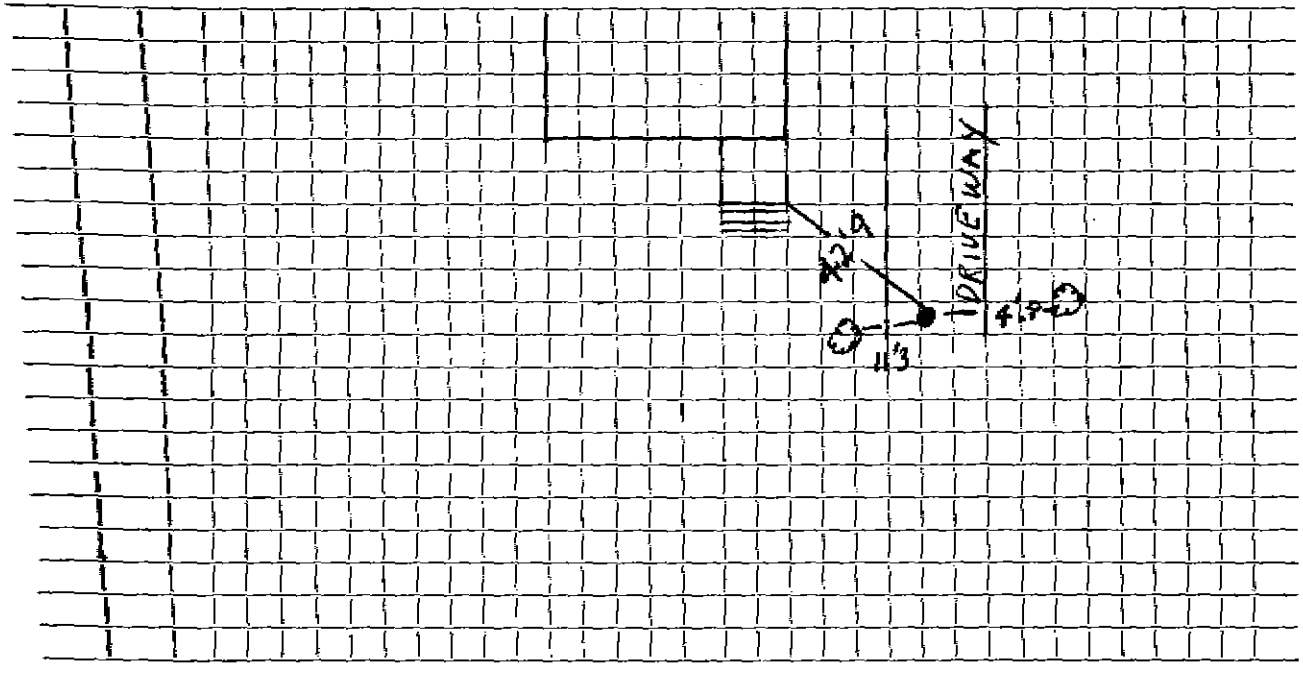

Connection made in . . . . . Street. Work completed . . . . . .

Remarks: . . . . . .

. . . . . .

. . . . . .