R.B.M.15010

WATER SERVICE RECORD

Name Arthur W. Johnson **Service No.** 45

Address 15A Crescent Hill Avenue

Location

~~Remove Renewal~~—New Service WO #7223 Comm 7-16-62

Date	Material	Amount	Total
5/17/62	Labor	2 13	
	10% O.H.	21	2 34
	40' 3/4" Copper Tubing @ .42		16 80
	1 3/4" C x ½ I.W.H. Stop & Waste		6 17
			25 31

Date		Amount
5-8-62	Deposit	50 00
7-16-62	Refund	24 69
		25 31

Curb to Main

Date		Amount
5/17/62	Labor	1 93
	9' 3/4" Copper Tubing @.42	3 78
	1 3/4" C Corp Cock	4 91
	1 3/4" C Curb Cock	6 28
	1 Bow & Rod	4 90
	1 ½ Straight Tailpiece	50
	1 ½ Offset Tailpiece	50
		22 80

DATE _____

TOWN OF LEXINGTON — BOARD OF PUBLIC WORKS

WATER DIVISION

Sketch of Service Here

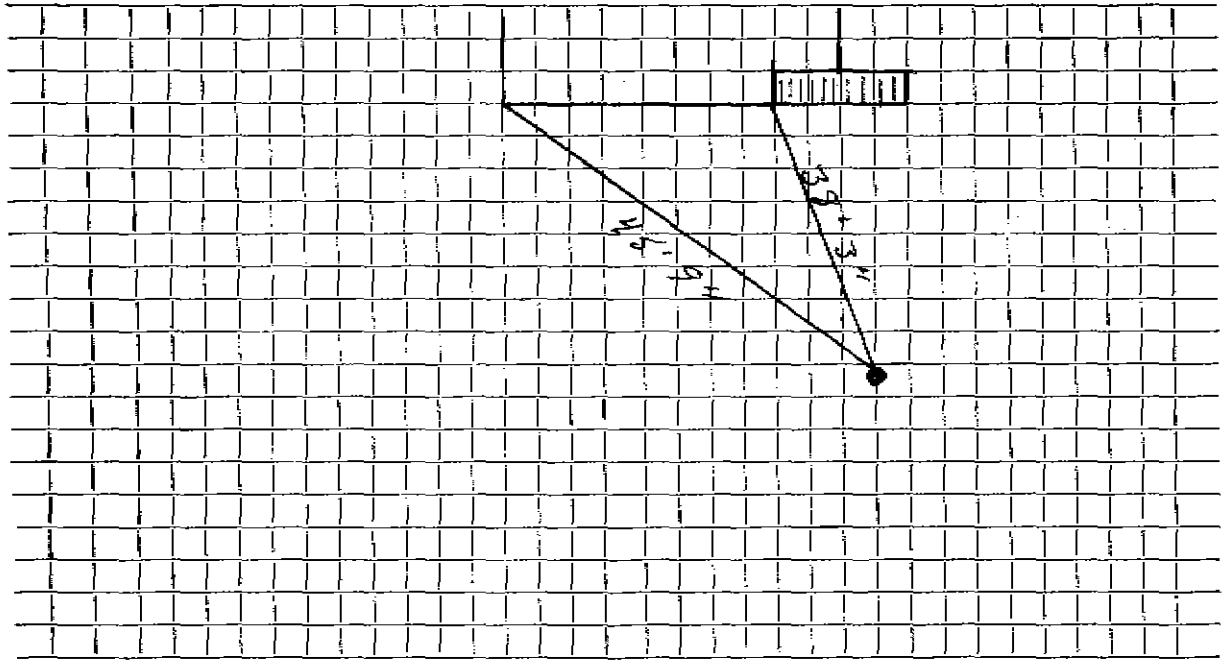

Connection made in ..... Street. Work completed .....

Remarks: .....

.....

.....