Water Service Record

Name

Service No.

Address 19 Crescent Hill Ave

Location

Repair Renewal - New Service

Date	Material	Amount	Total	Date		Amount
10/7/21	1" type K copper					
	1" curb stop					
	open right					
	comb. brass					
	1" copper to					
	iron coupling					

Date: 10/7/21

TOWN OF LEXINGTON - BOARD OF PUBLIC WORKS
WATER DIVISON

SKETCH OF SERVICE HERE

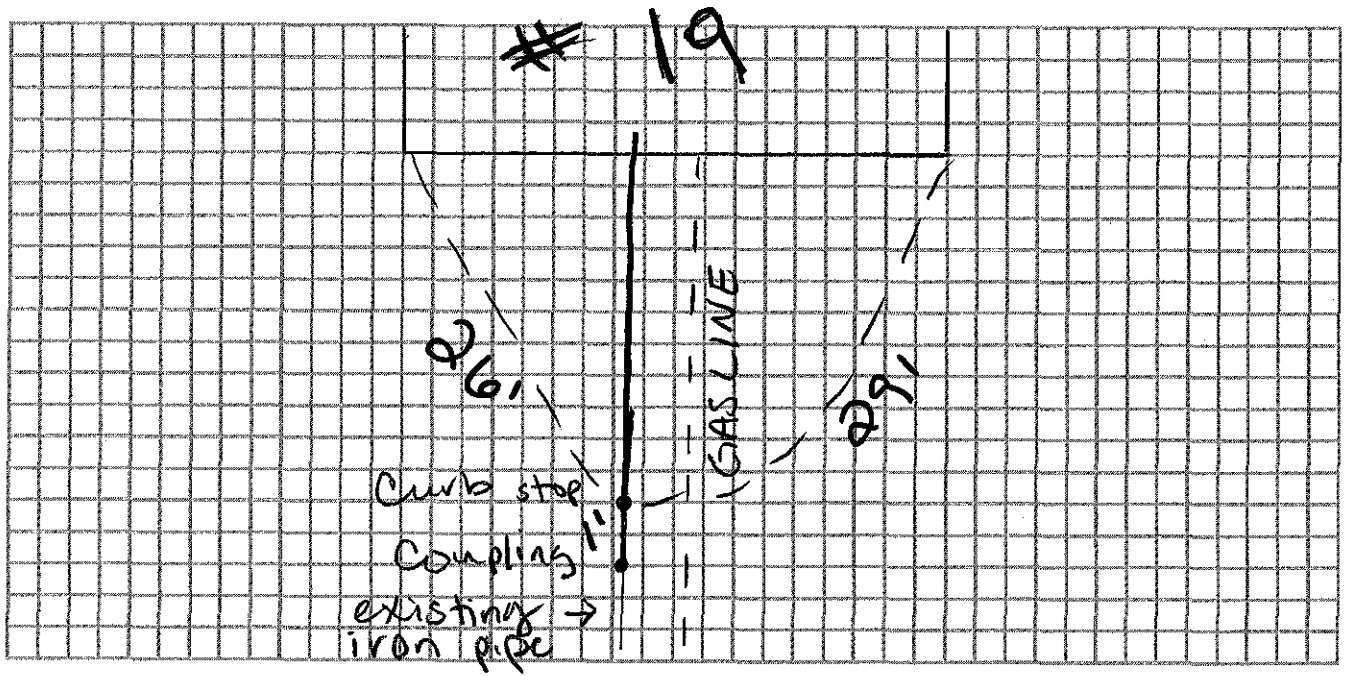

Connection made in: Crescent Hill Ave Street. Work completed:

Remarks: