Name E. Hanson

Address 29 Lincoln Street, Waltham

Service No. ~~68~~ 708 ~~#~~ 965

Location Lot #12; st. #4 Daniels St.,

Kind of Pipe

Size

Size of Main

~~Repairs~~ ~~Renewals~~—New Service 50' @ 50¢ 25.00

Location

Date 1937	Material	Amount	Total	Date		Amount
Oct. 11,	2 hrs @ 60¢	1 20	1 20	Oct 6, 1937	Deposited	25.00
	50' 3/4" Cop. Tub.	@ 25¢	12 50			
	1 3/4" S. & W.		3 75			
	2 hrs. trucking	@ 75¢	1 50			
			18 95			
	Flat Rate:					
	50' @ 50¢		$25 00			
	Labor					

Hadley Press, Inc., Lexington

DATE Oct 6 1937

TOWN OF LEXINGTON—BOARD OF PUBLIC WORKS

WATER DIVISION

The undersigned applies for a supply of water at No. Lot #12 - G. Daniels St. and hereby agrees to comply with the rules and regulations as now, or at any future time, established by the Board of Selectmen.

Am't. of Estimate $ _____

Am't. Paid $ _____

Builder _____

Owner _____

Address _____

Sketch of Service Here

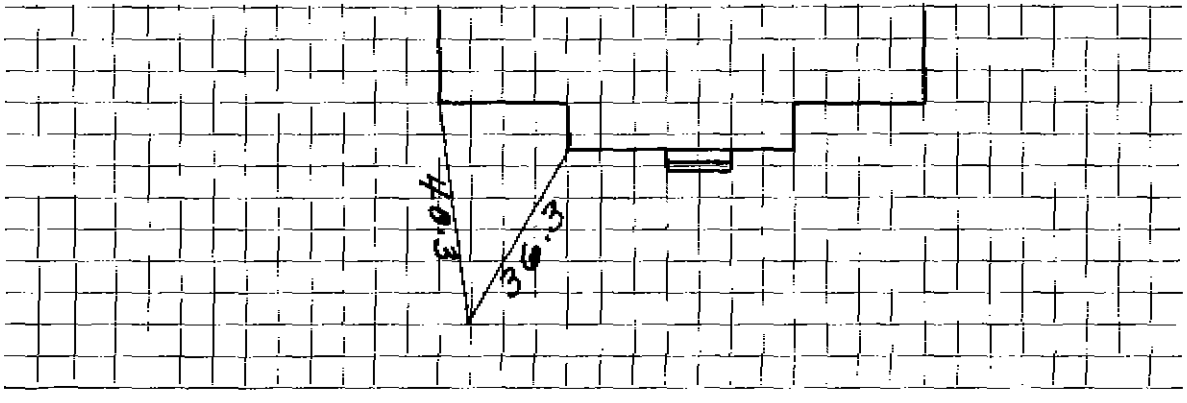

Connection made in _____ Street. Work completed _____ 19

Remarks: