WATER SERVICE RECORD

Name

Service No. 3187

Address 33 Dawes RD

Location

LOT-1

Repair—Renewal—New Service J. Mclaughlin

Date		Material	Amount	Total	Date			Amount
12/1/08	93'	1" Copper			11/1/57	38'	3/4 Copper	
	1	3/4X1" increser				1	3/4 Corp	
	1	bufflebox				1	3/4 Curb STop	

DATE _____

TOWN OF LEXINGTON — BOARD OF PUBLIC WORKS

WATER DIVISION

Sketch of Service Here

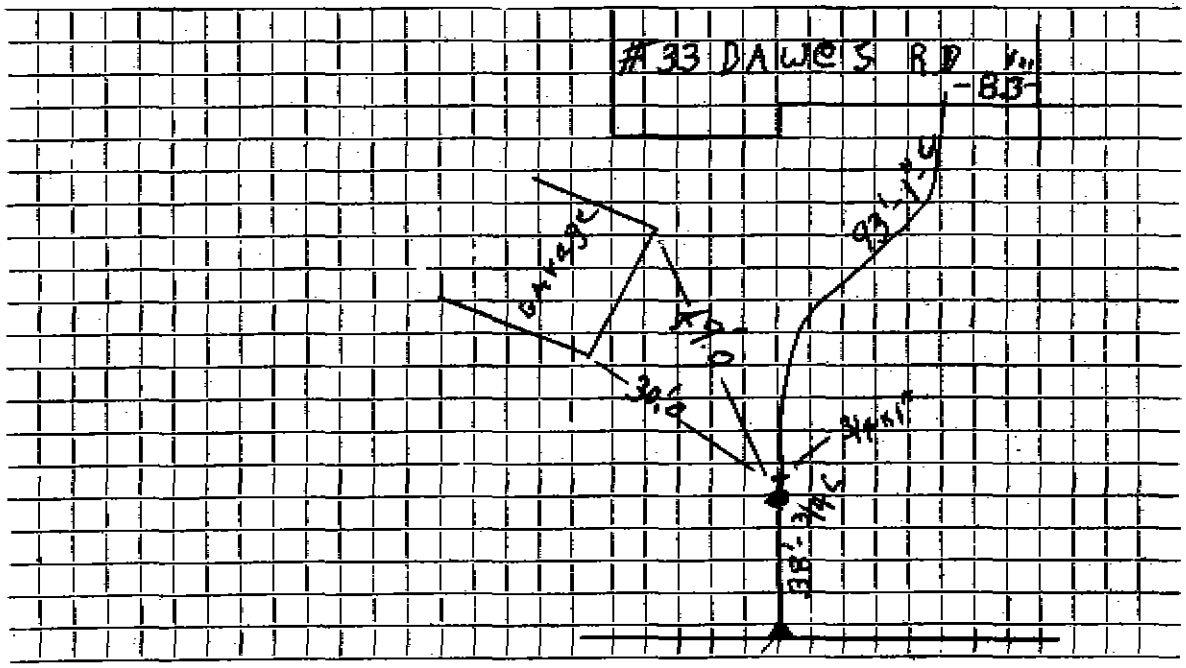

Connection made in ..... Street. Work completed 12/1/08 J. McLaughlin

Remarks: .....

WATER SERVICE RECORD

Name

Service No. 3187

Address 33 Dawes RD

Location

LOT-1

Repair—Renewal—New Service J. Mclaughlin

Date		Material	Amount	Total	Date			Amount
12/1/08	93'	1" Copper			11/1/57	38'	3/4 Copper	
	1	3/4X1" increser				1	3/4 Corp	
	1	bufflebox				1	3/4 Curb STop	