WATER SERVICE RECORD

Name *Deposister Trust* **Service No.**

Address *10 Depot Square*

Location

Repair—Renewal—New Service

Date		Material	Amount	Total	Date			Amount
5/28/85	30'	1" Copper tubing						
	1	1" Valve						
							OUTSIDE	
					5/28/85	327'	1" Copper tubing	
						4	1" Unions (Flare)	
						2	1" Curbs	
						1	1" Corp	
						1	Curb Box & Rod	
						1	Roadway Box	

DATE _____

TOWN OF LEXINGTON — BOARD OF PUBLIC WORKS

WATER DIVISION

Sketch of Service Here

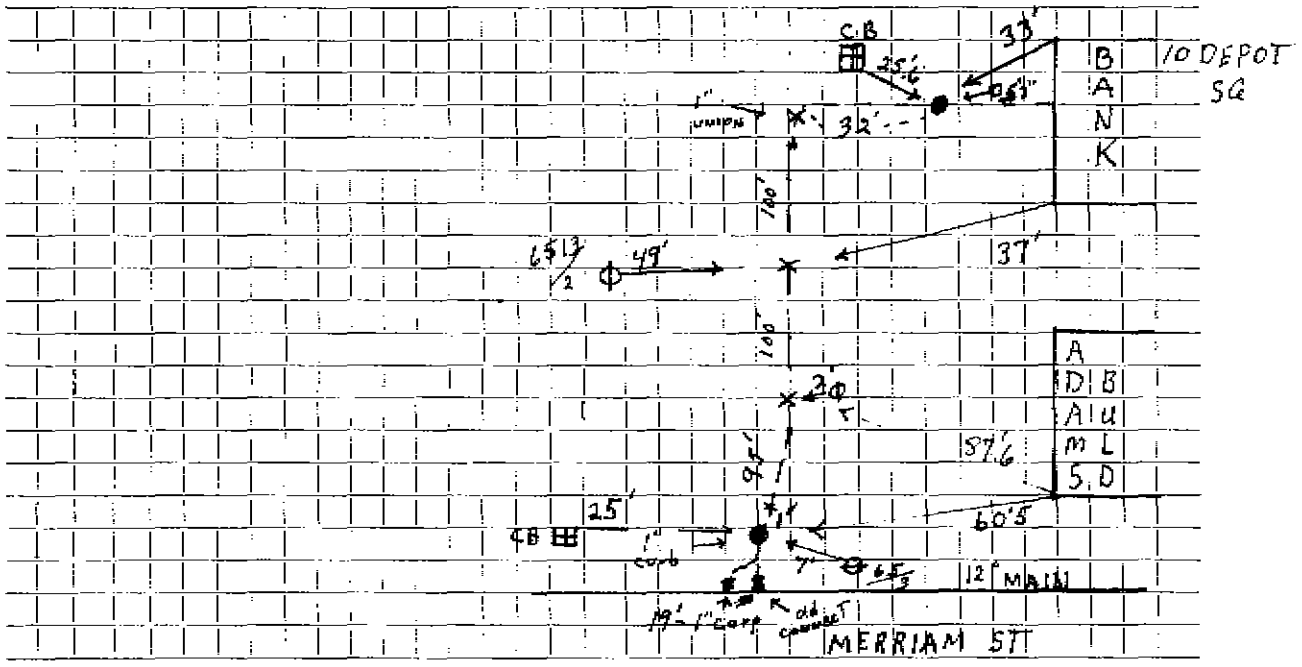

Connection made in ..... Street. Work completed .....

Remarks: .....

.....

.....