K.B.M.16010

#3039

WATER SERVICE RECORD

Name Gerald D. Shirley **Service No.** 6815

Address 29 Dewey Road

Location Lot 11

~~**Repair**~~ ~~**Renewal**~~ **New Service** J.M.Lucente Permit #34 Lexington Sewerage Co. # 519

Date		Material	Amount		Total		Date			Amount	
July '64	40'	3/4" Copper tubing									
1/25/67		119'3/4"Copper									

DATE _____

TOWN OF LEXINGTON — BOARD OF PUBLIC WORKS

WATER DIVISION

Sketch of Service Here

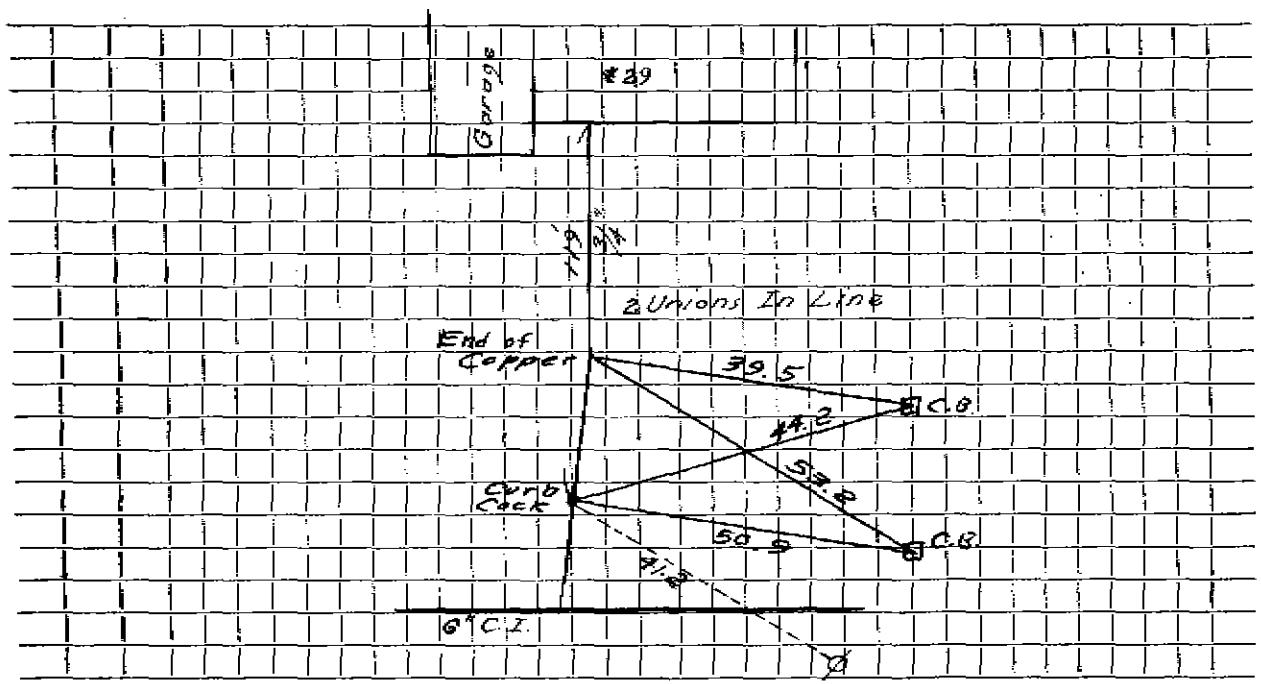

Connection made in ..... Street. Work completed .....

Remarks: .....

.....

.....