WATER SERVICE RECORD

Name **Service No.**

Address #258 ~~[illegible]~~ [illegible]

Location

Repair—Renewal—New Service

Date	Material	Amount	Total	Date		Amount
Aug. 4 86						
	1 Corp. 1"					
	1 c/c's box					
	550" of 1" copper					
Sept						
	450" of 1" copper					

DATE _____

TOWN OF LEXINGTON — BOARD OF PUBLIC WORKS

WATER DIVISION

Sketch of Service Here

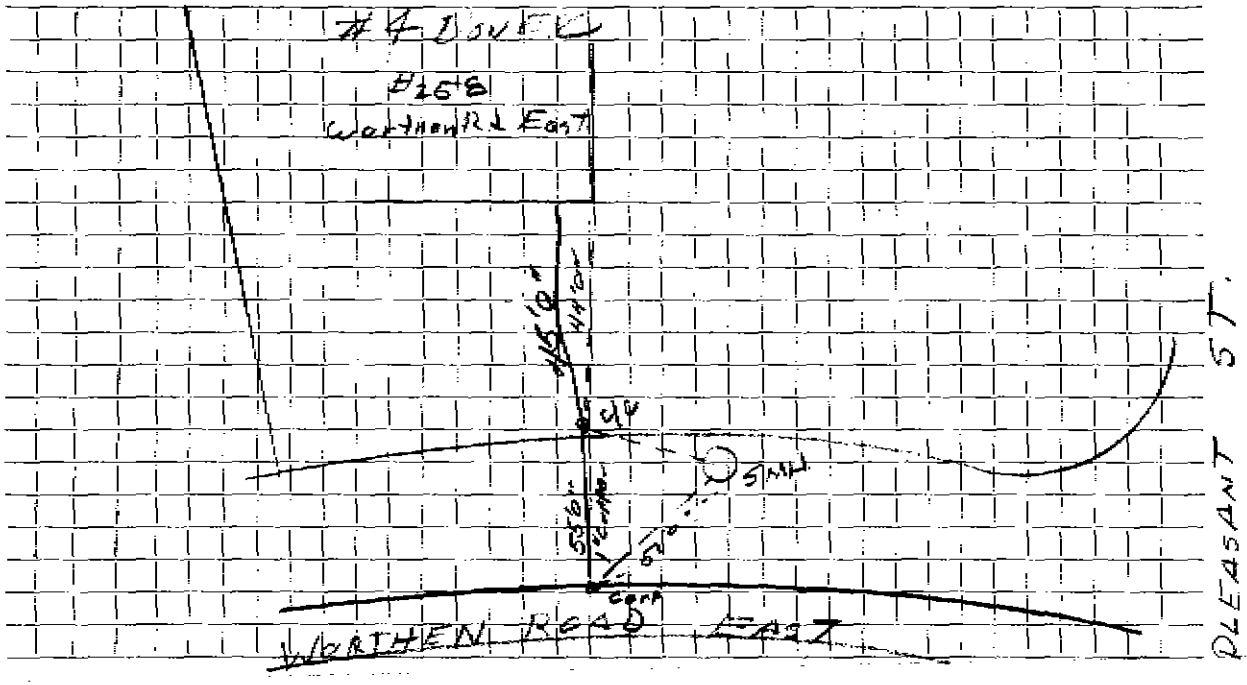

Connection made in ..... Street. Work completed .....

Remarks: .....

.....

.....