B.B.M.16010

WATER SERVICE RECORD

Name Duffy Bros.

Service No. #6892

Address 12 Dudley Road

Location lot #215

Repair—Renewal—New Service Bonanno #1396 & 1493

Date		Material	Amount		Total		Date			Amount	
	30'	3/4" Copper tubing									
10-17-69	45'	3/4" Copper tubing									

DATE _____

TOWN OF LEXINGTON — BOARD OF PUBLIC WORKS

WATER DIVISION

Sketch of Service Here

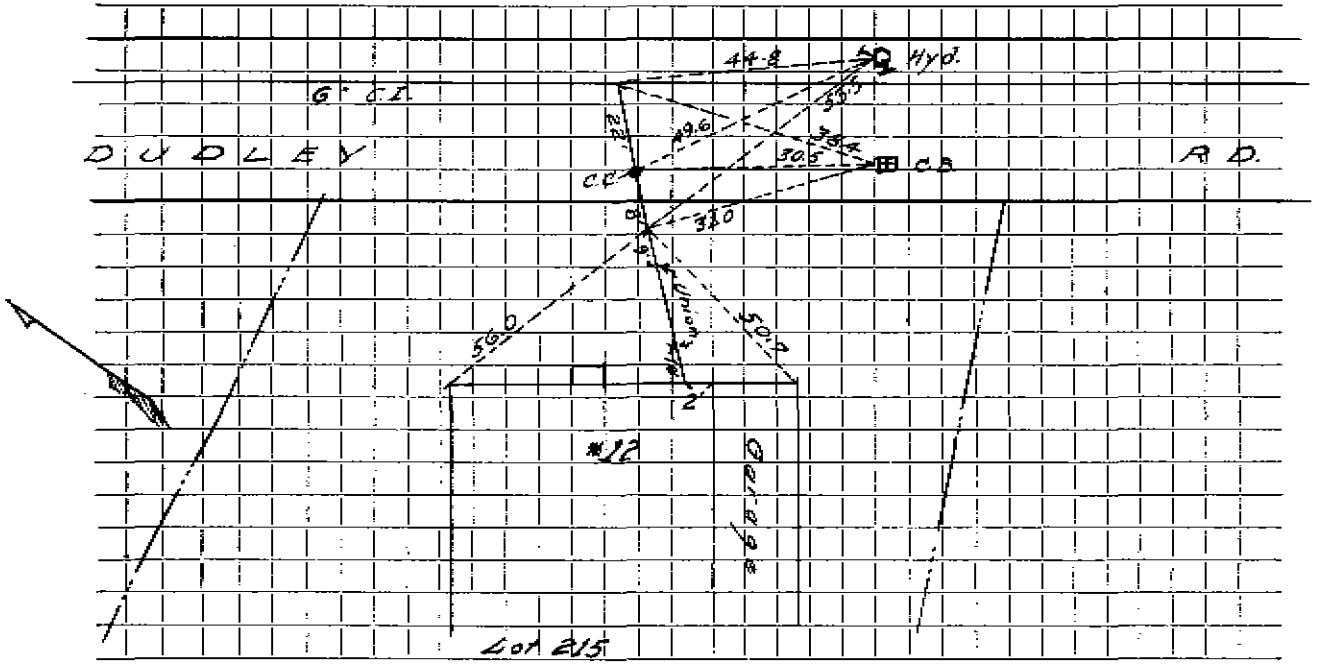

Connection made in ..... Street. Work completed .....

Remarks: .....

.....

.....