H.B.M.16010

WATER SERVICE RECORD

Name Duffy Bros.

Service No.

Address 6 Dudley Road

Location

Repair—Renewal—New Service Bonanno #1392
Bonanno #1438

Lot 218

Date		Material	Amount		Total		Date			Amount	
8-14-69	55'	3/4" Copper tubing									
11-12-69	38'	3/4" Copper tubing									

DATE _____

TOWN OF LEXINGTON — BOARD OF PUBLIC WORKS

WATER DIVISION

Sketch of Service Here

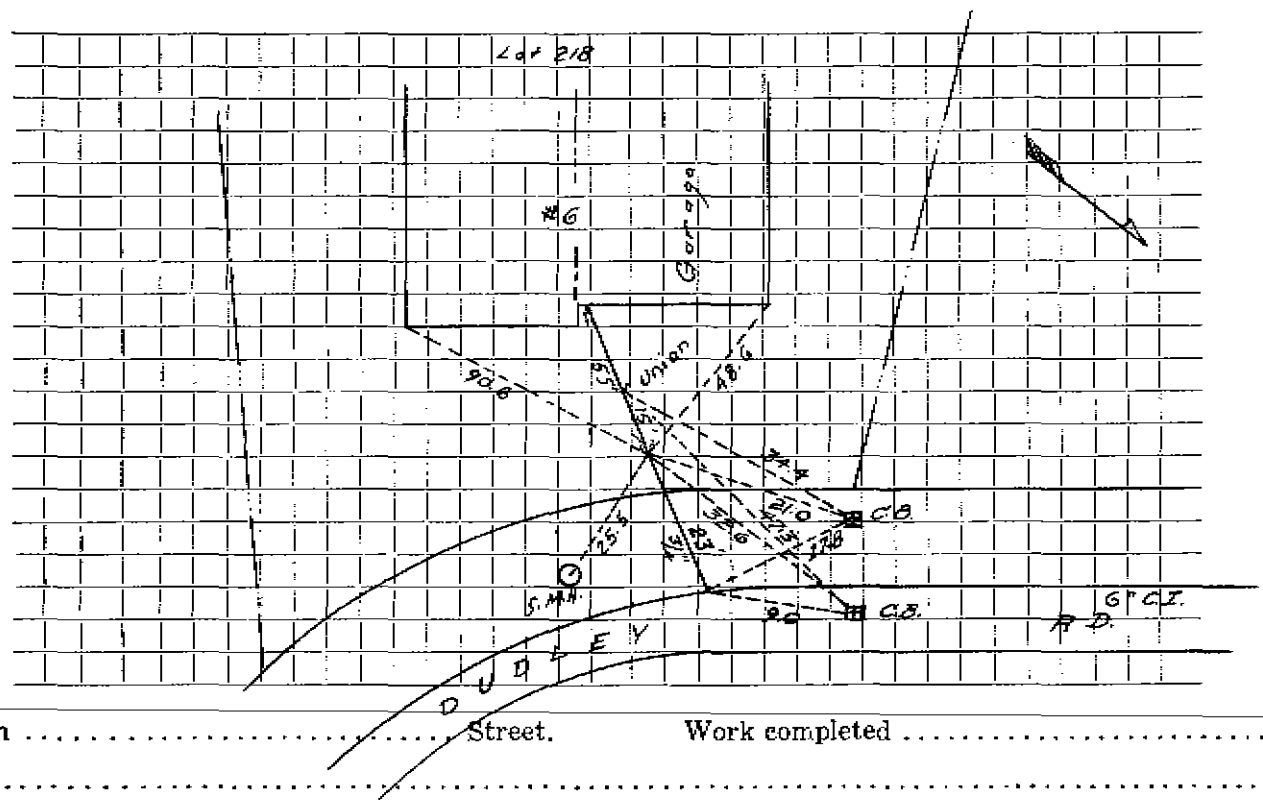

Connection made in ..... Street. Work completed .....

Remarks: .....

.....

.....