WATER SERVICE RECORD

Name Prescott Village Realty

Service No.

Address 109 EAST EMERSON LOT #26

Location

Repair—Renewal—New Service Bicentennial #4567

Date	Material	Amount	Total	Date		Amount
1984	20 LF 1" COPPER					
	1" CORP					
	1" CURB w/BOX					
7/86	48 LF 1" COPPER					

DATE _____

TOWN OF LEXINGTON — BOARD OF PUBLIC WORKS

WATER DIVISION

Sketch of Service Here

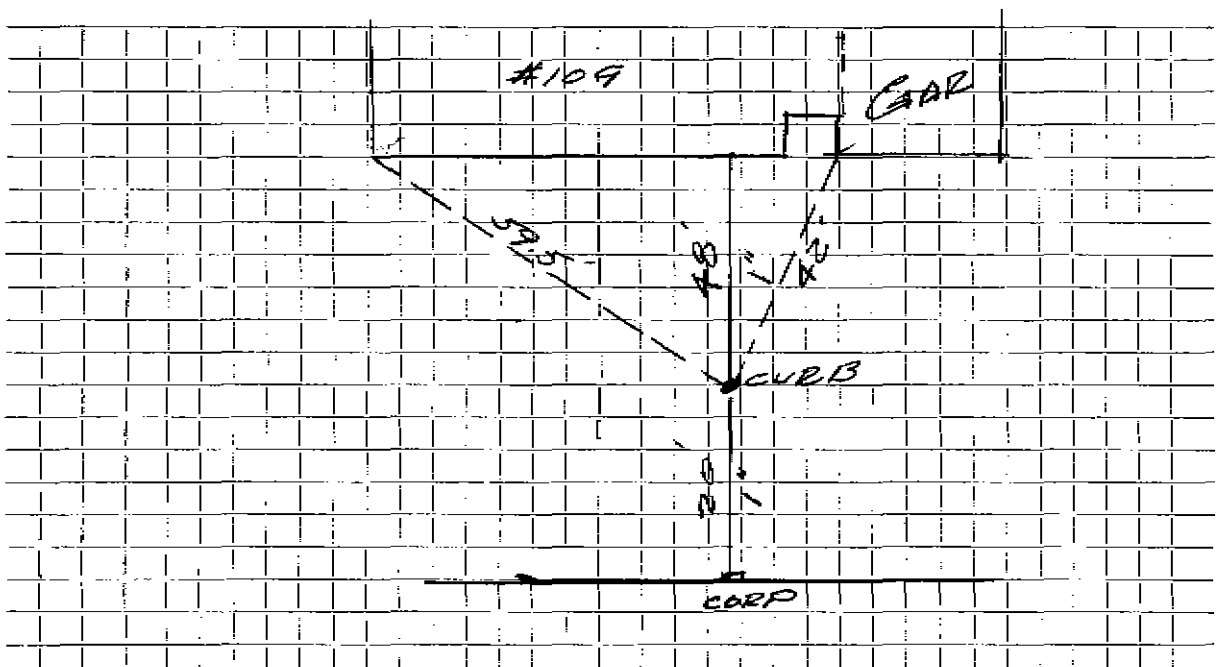

Connection made in EAST EMERSON ..... Street. Work completed .....

Remarks: .....

.....

.....