E.B.M.16010

WATER SERVICE RECORD

Name Moore Homes **Service No.** 52 N.D

Address 123 East Street

Location Lot#2.

~~Repair, Renewal~~—New Service W.O.#1858. JAN 21 1980

Date		Material	Amount	Total	Date		Amount
3-8-'74		Labor	52.04		1-21-80	Paid by WHC#23	115.56
		10% O.H.	5.20	$57.24	1-21-80	Paid by WHC# 49	91.52
	92'	3/4" Copper @1.05		96.60			207.08
	1	3/4" Corporation		10.53			
	1	3/4" Curb		12.45			
	3	3/4" 3 Part Unions		4.26			
	1	Box & Rod		10.00			
	2	Hrs. Town Shovel @6.50		13.00			
	1	Box Trucking		3.00			
				$207.08			

DATE_____

TOWN OF LEXINGTON — BOARD OF PUBLIC WORKS

WATER DIVISION

Sketch of Service Here

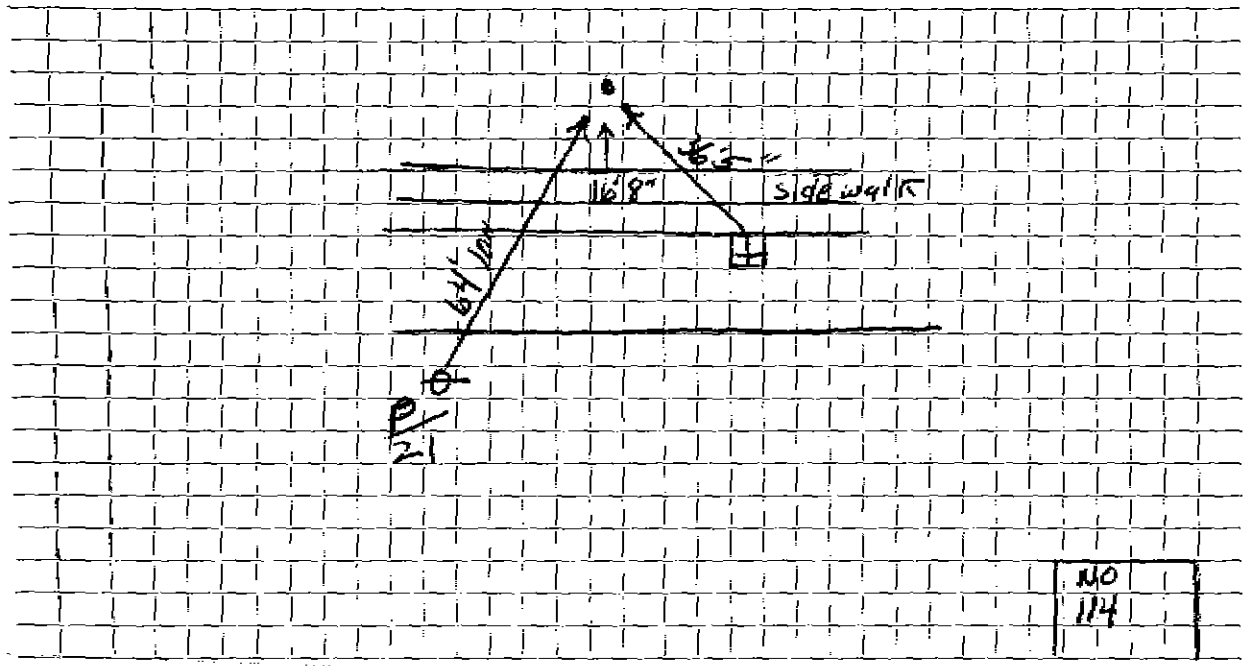

Connection made in ..... Street. Work completed .....

Remarks: .....

.....

.....