WATER SERVICE RECORD

Name **Service No.**

Address 240 EAST ST

Location

Repair—Renewal—New Service

Date	Material	Amount	Total	Date		Amount
	INSIDE					
1-4-01	54' 1" COPPER					
	1 3/4X1" UNION					
	1 BUFFALO BOX					

DATE_____

TOWN OF LEXINGTON — BOARD OF PUBLIC WORKS

WATER DIVISION

Sketch of Service Here

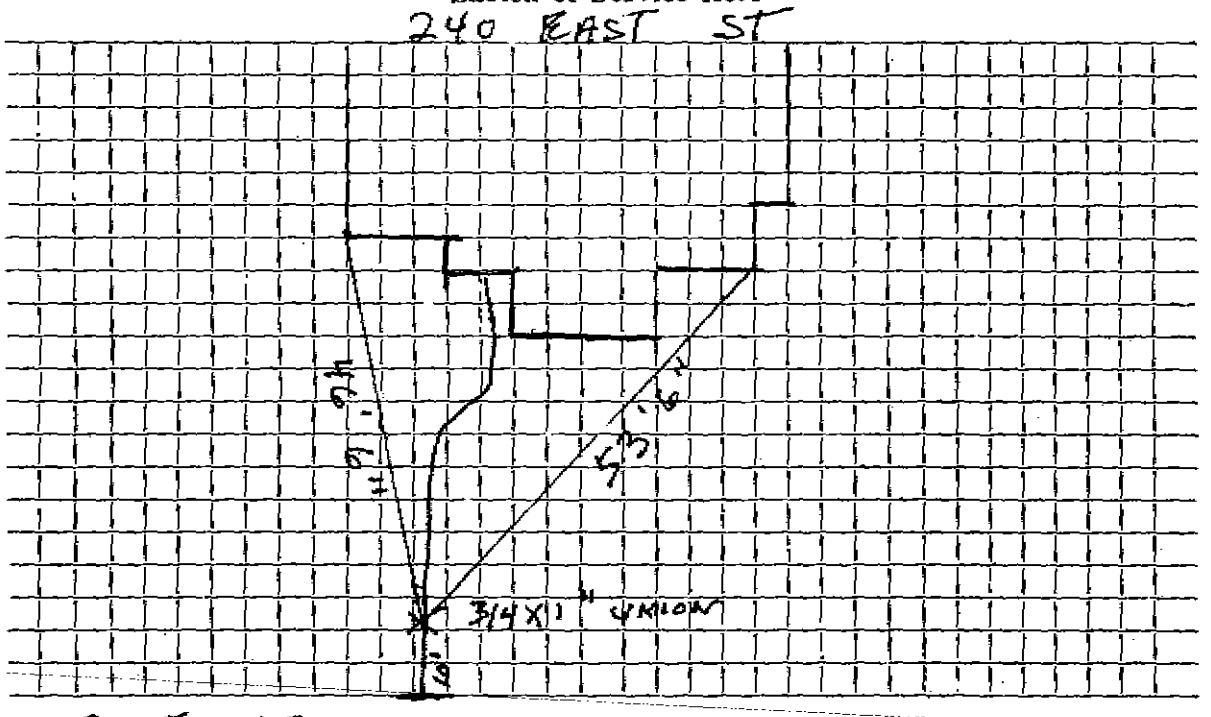

Connection made in ...EAST...ST..... Street. Work completed .....

Remarks: .....

.....

.....