R.B.M.16010

WATER SERVICE RECORD

Name William I. Burnham **Service No.** 134

Address 30 East Street

Location

x~~Repair~~ x~~Renewal~~—New Service Comm. 9-3-57

Date	Material	Amount	Total
7/16/57	Labor	79 98	
	10% overhead	8 00	87 98
	34' - 3/4" Copper tubing @ .4228		14 38
	230' - 1" Copper tubing @ .5202		119 65
	1 - 3/4"Cx½ I.W.H. Stop & Waste		4 96
	2 - 1" Unions (2 part) @ 1.40		2 80
	1 - 1" Copper Tee		3 90
	15 Sticks Dynamite @ .17		2 55
	6 Caps @ .12		72
	6 hrs. Town Shovel @ 6.50		39 00
	2 hrs. Trucking @ .75		1 50
	2 hrs. Compressor @ 3.00		6 00
	2 hrs. Allis Chalmers Bulldozer @ 3.00		6 00
	2 hrs. Hough Loader @ 3.00		6 00
	22x3 Patch - Street		22 00
	~~45x3 Driveway Patch~~		~~45 00~~
			362.44

Date		Amount
7-15-57	Deposit	$350 00
9/25-57	Paid	12 44
		$362 44
	NON CHARGE	
7/17/57	Labor	44 18
	26' - 1" Copper tubing @ .5202	13 53
	1 - 3/4" Curb Cock	4 64
	2 Boxes & Rods @ 4.62	9 24
	1 - 1" Corp Cock	5 61
	1 - 1" Curb Cock	6 49
	1 - ½ Straight tailpiece	50
	1 - ½ Offset tailpiece	50
	2 hrs. Town Shovel @ 6.50	13 00
	1 hr. Trucking	75
	1 hr. Allis Chalmers	3 00
		104 90

Bill Jr. 10-5-57

DATE _____

TOWN OF LEXINGTON — BOARD OF PUBLIC WORKS

WATER DIVISION

Sketch of Service Here

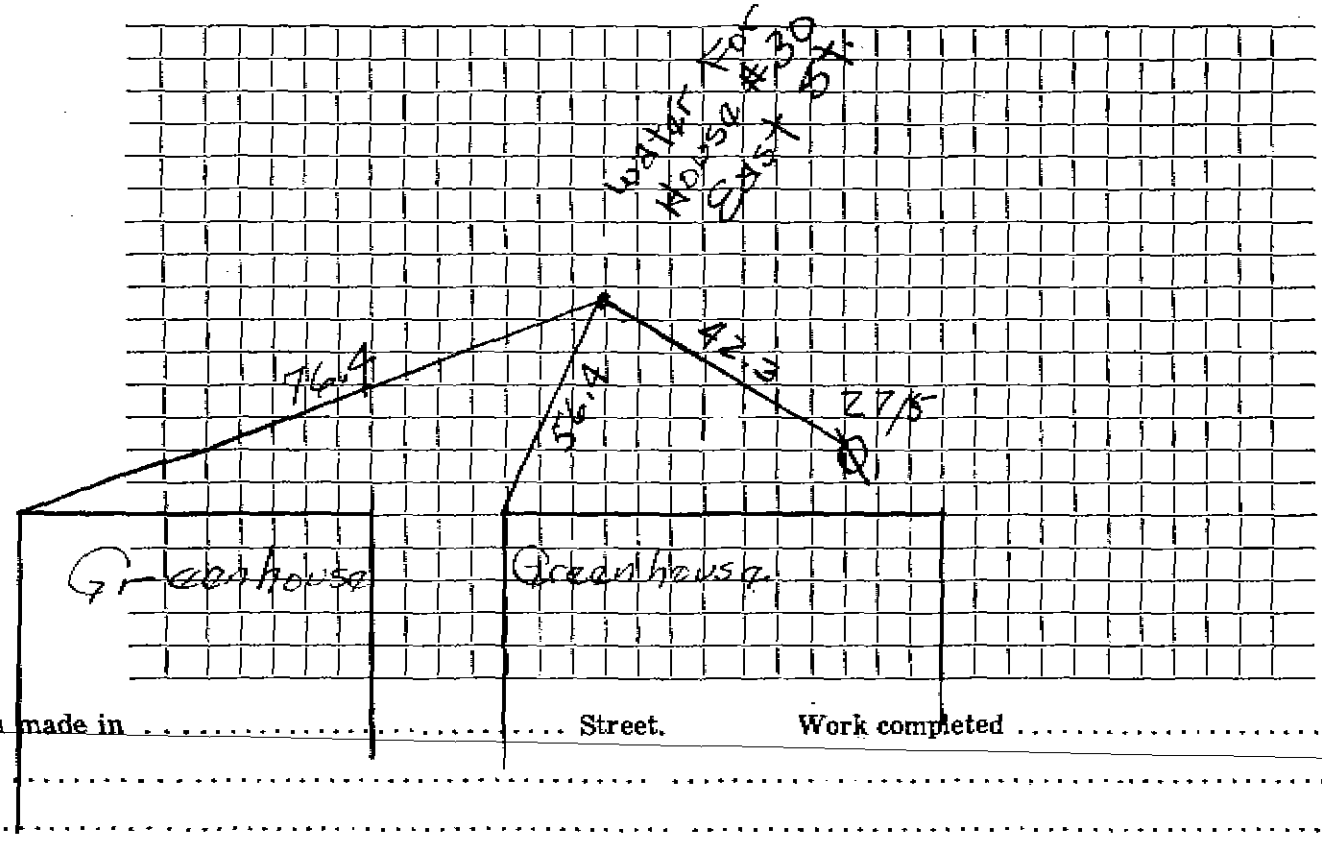

Connection made in ..... Street. Work completed .....

Remarks: .....

.....

.....