Name John Craig **Service No.** 5099

Address 98 East Street

Lexington, Mass. **Location** 98 East Street

Kind of Pipe **Size** **Size of Main**

~~Repair~~ ~~Renewal~~ **New Service** **Location**

Date	Material	Amount	Total
June 9, '48	Labor	3 15	3 15
	10% Overhead		32
	38' - 3/4" Copper Tubing @.255		9 69
	1 - 3/4" C x ½" I.W.H. S & W		3 15
	Trucking 1 hr. @.75		75
	Patching 18 x 3		18 00
			35 06
	Completed 10/25/48		
	Trench dug by owner		
	Labor		

Date		Amount
June 5, '48	Deposited	40 00
Oct 25 '48	Refunded	4 94
	Non-Charge	35 06
June 9, '48	Labor	27 75
	24' - 3/4" Copper Tubing @.255	6 12
	1 - 3/4" C Corp-cock	3 00
	1 - 3/4" C x 3/4" C Curb-cock	3 68
	1 - Box & Rod	3 55
	1 - ½" Straight Tail Piece	30
	1 - ½" Offset Tail Piece	30
	Trucking 1 hr. @.75	75
		45 45

DATE

TOWN OF LEXINGTON – BOARD OF PUBLIC WORKS

WATER DIVISION

The undersigned applies for a supply of water at No..... St. and hereby agrees to comply with the rules and regulations as now, or at any future time, established by the Board of Selectmen.

Am't of Estimate $..... Owner .....

Am't Paid $..... Address .....

Builder ....

Sketch of Service Here

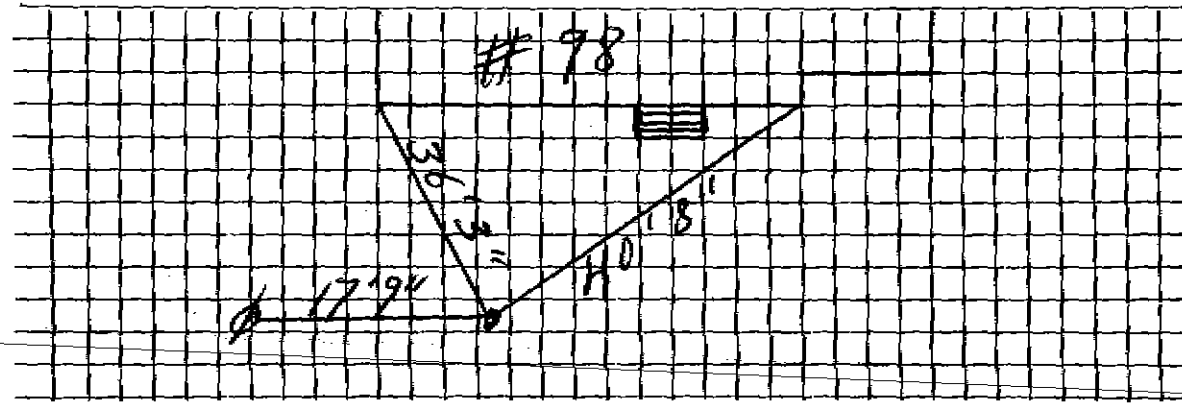

Connection made in ..... Street. Work completed 19

Remarks: