E.3.N.16010

WATER SERVICE RECORD

Name F. William Smith (East Village Square) **Service No.**

Address 9 and 10 East Village Square

Location

Repair—Renewal—New Service DeFlice Bros. #2814

Date		Material	Amount	Total	Date		Amount
4/6/76	29'	1" Copper Tubing					
	41.5'	3/4" Copper Tubing					

DATE _____

TOWN OF LEXINGTON — BOARD OF PUBLIC WORKS

WATER DIVISION

Sketch of Service Here

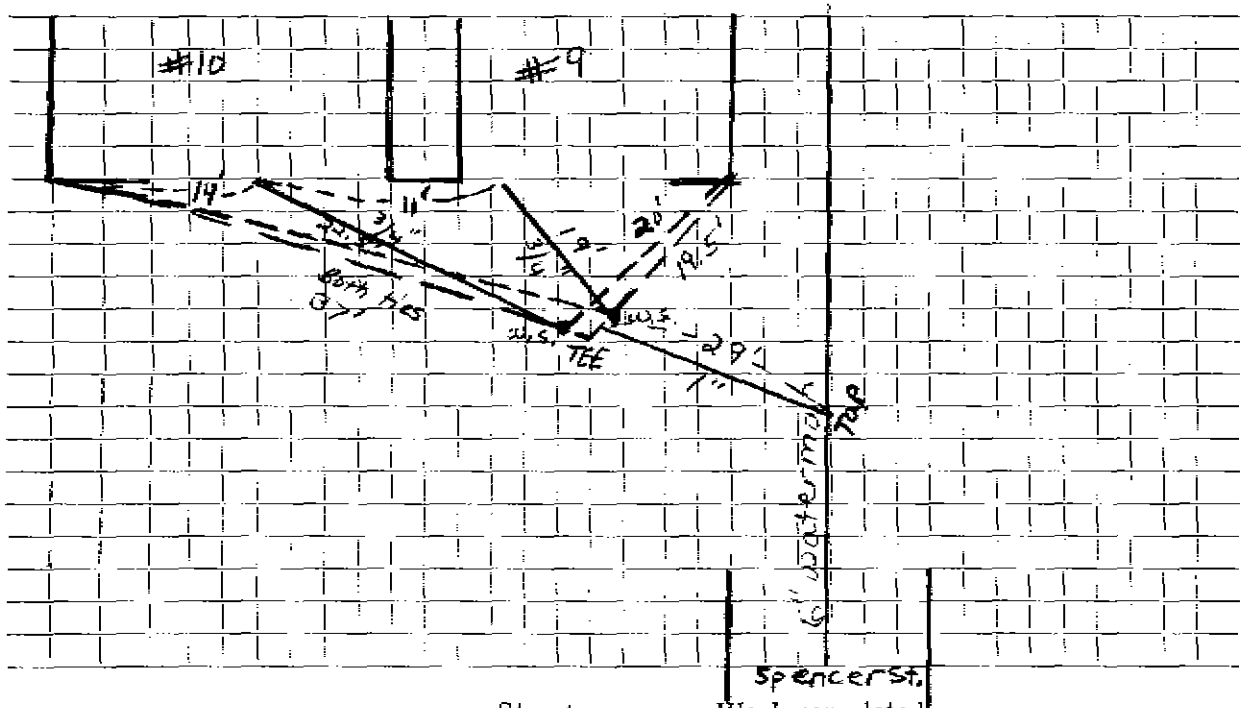

Connection made in ..... Street. Work completed .....

Remarks: .....

.....

.....