WATER SERVICE RECORD

Name **Service No.**

Address Edisson Way.

Location Mass Ave Numbers 1707, 1709, 1735

Repair—Renewal—New Service

Date	No	Material	Amount	Total	Date		Amount
CVS 1735		6" W. DICL -	Sprinkler				
Gate 6"	for	Hyd -					
D-D-1767		1" - copper					
"		1" curb + 1" Corp - buffalo box					
1709		6" W. DICL	Sprinkler				
"		4" W DICL					

DATE _____

TOWN OF LEXINGTON — BOARD OF PUBLIC WORKS

WATER DIVISION

Sketch of Service Here

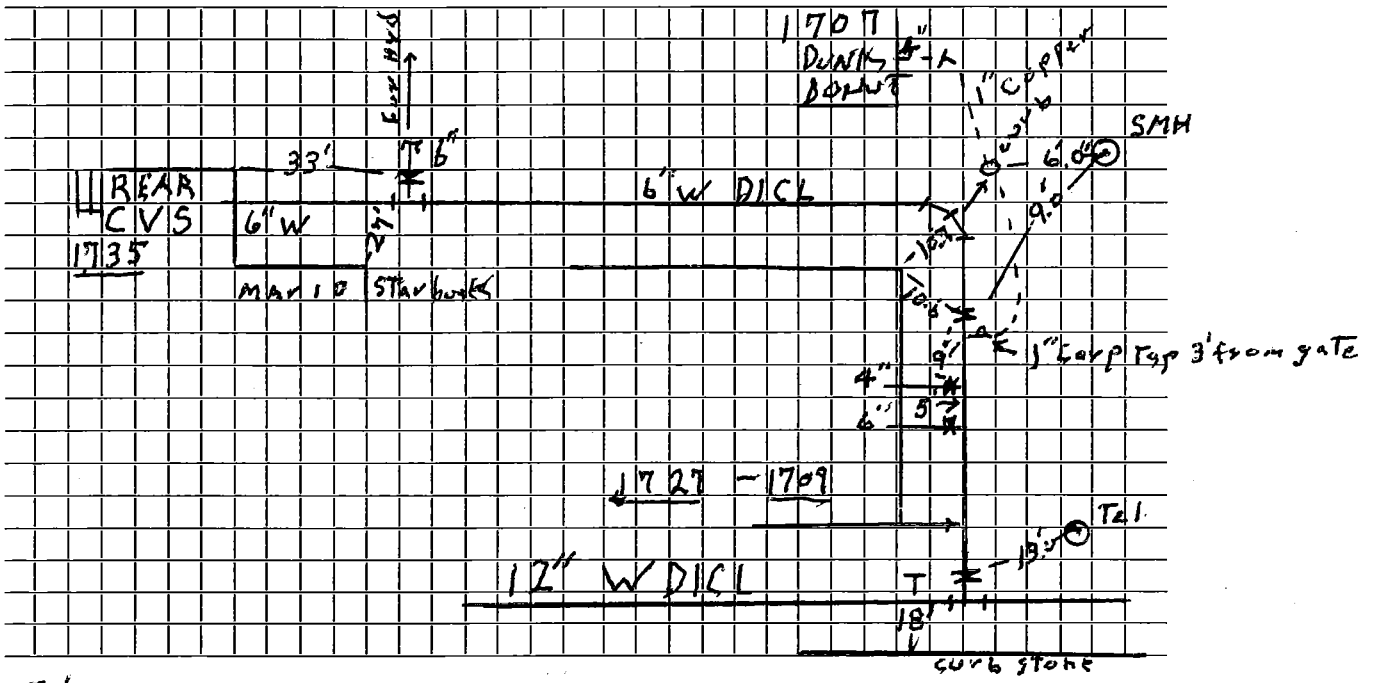

Connection made in Ed. Way Street. Work completed _____

Remarks: 1707 Dunk. D. has 4" Glass Through Wall with 4" Cap: Taped 1" Tie 23-7

1709 - 6" W + 4" W - DICL

CVS 1735 - 6" Sprinkler