B.B.M.16010

WATER SERVICE RECORD

Name **Service No.**

Address 11 Elena Road

Location

Repair—~~Renewal~~—New Service DeFlice Brothers - Permit #571

Date		Material	Amount		Total		Date			Amount	
6/9/67	44'	3/4" Copper					10/18/66				
								37'	3/4" Copper		

DATE _____

TOWN OF LEXINGTON — BOARD OF PUBLIC WORKS

WATER DIVISION

Sketch of Service Here

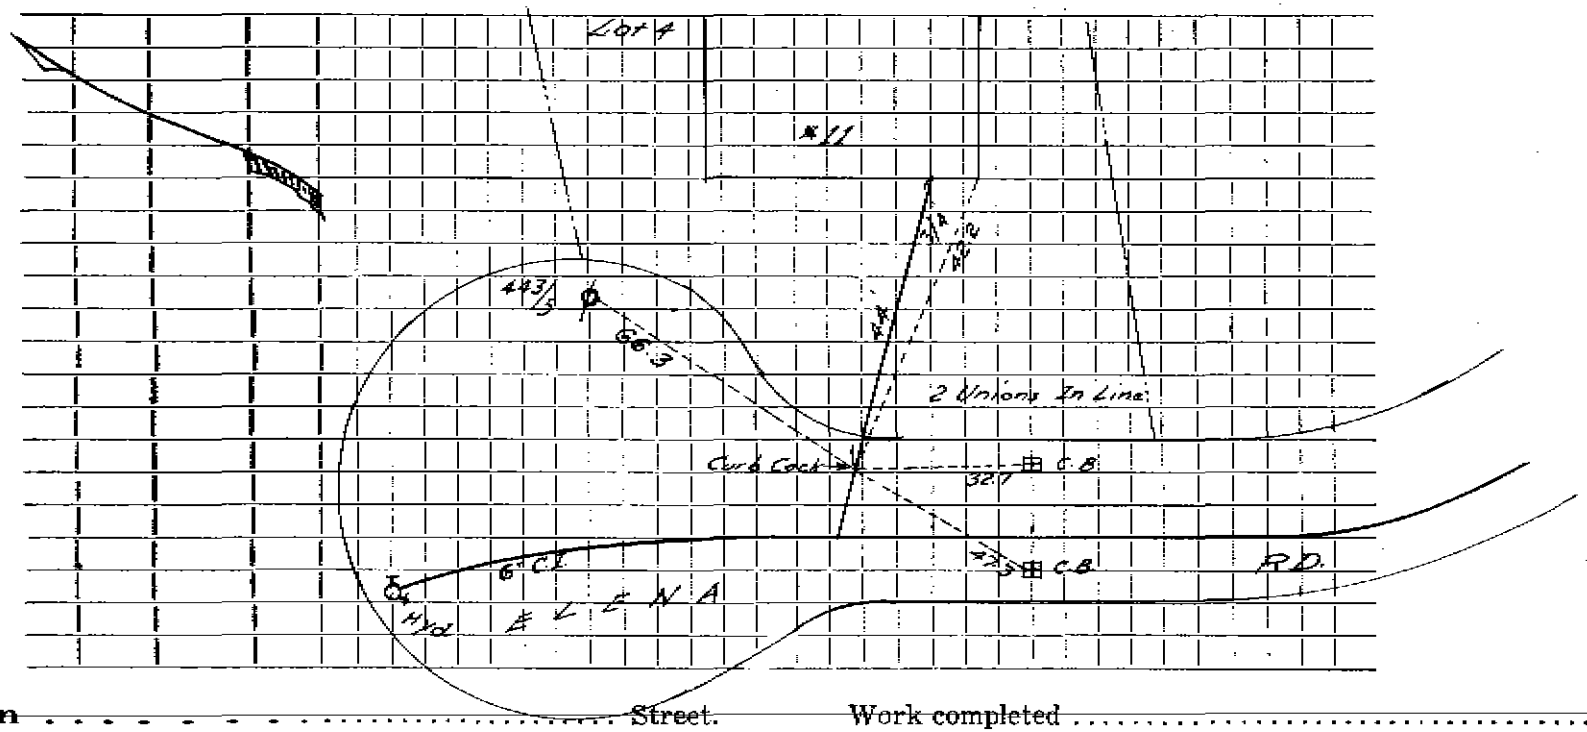

Connection made in . . . . . Street. Work completed . . . . . .

Remarks: . . . . . .

. . . . . .

. . . . . .