R.B.M.16010

WATER SERVICE RECORD

Name R. J. Foley Realty

Service No. #2253

Address 6 Elena Road

Location Lot #9

Repair—Renewal—New Service DeFlice Bros #513

Date		Material	Amount		Total		Date			Amount	
1/3/67	40'	3/4" Copper tubing					10/18/66	21'	3/4" Copper Tubing		
								1	3/4" Corp Cock		
								1	3/4" Curb Cock		
								1	Box & Rod		

DATE _____

TOWN OF LEXINGTON — BOARD OF PUBLIC WORKS

WATER DIVISION

Sketch of Service Here

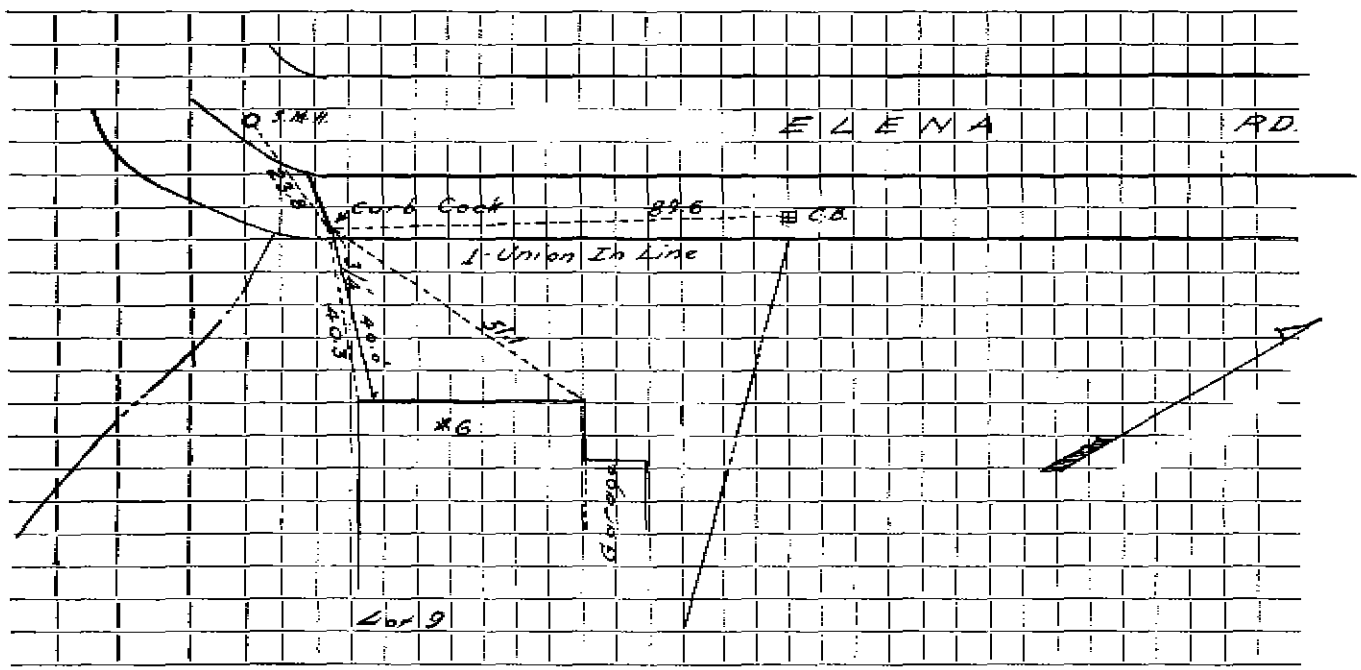

Connection made in ..... Street. Work completed .....

Remarks: .....

.....

.....