Water Service Record

Name

Service No.


Location

Repair - Renewal - New Service

Date	Material	Amount	Total	Date		Amount
5/19/20	1" type k copper					
	1" curb stop					
	open right					
	comb. brass					
	1" corporation					

Date: 5/15/2020

TOWN OF LEXINGTON - BOARD OF PUBLIC WORKS
WATER DIVISON

SKETCH OF SERVICE HERE

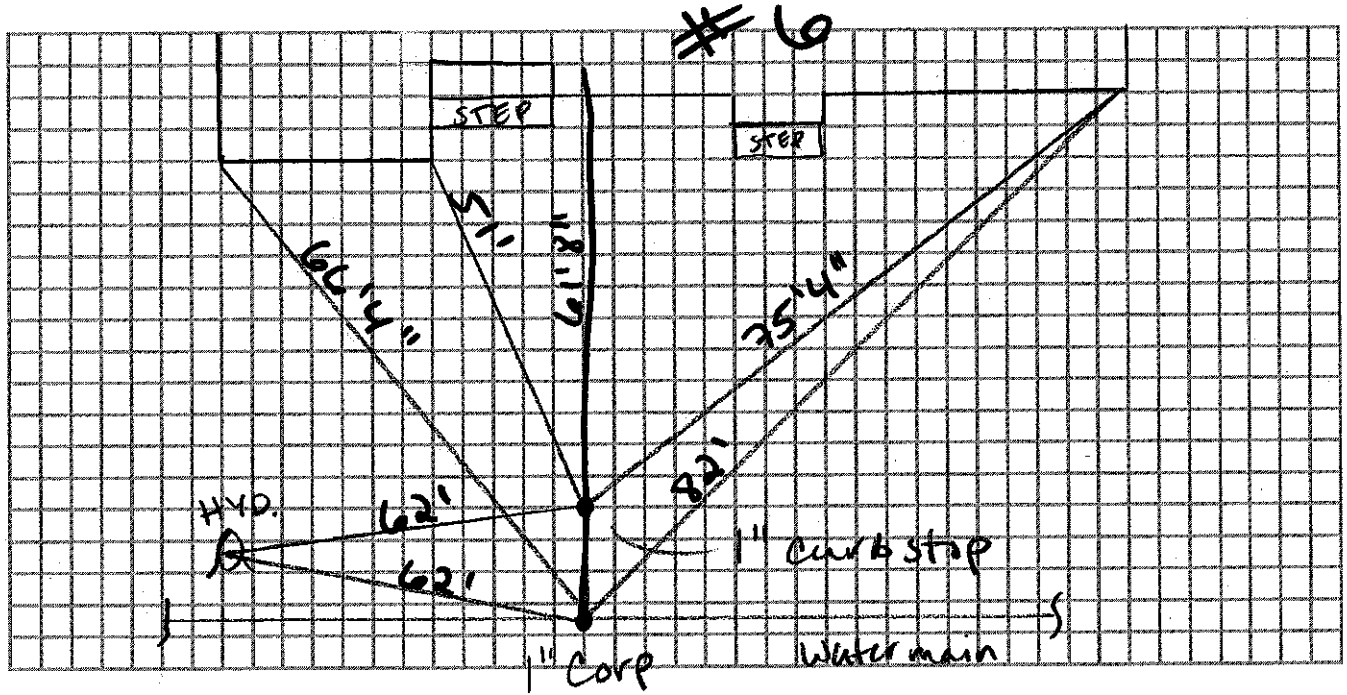

Connection made in: Eliot Rd Street. Work completed:

Remarks: