HP-676

WATER SERVICE RECORD

Name Walter Holman

Service No. 316

Address 28 ~~Summit Ave.~~ ESTABROOK Rd

Location

~~Repair~~ Renewal ~~New Service~~ Conn. 12-31-54

Date	Material	Amount	Total	Date		Amount
	27' - 3/4" copper tubing @ .35		9 45		No deposit	
	1 - 3/4"C x ½ I.W.H. stop & waste		4 00	6-14-55	Paid	13 45
5-23-90	4' 3/4 Copper		13 45			
	1 3/4 Comp Union			5-23-90	1-3/4" Corp Comp	
	TRENCH DUG AND PIPE LAID BY OWNER:				1-3/4 Curb Comp	
					18'-3/4 Copper	
					Box & Rod	
					Installed 1-4-55	

DATE _____

TOWN OF LEXINGTON — BOARD OF PUBLIC WORKS

WATER DIVISION

Sketch of Service Here

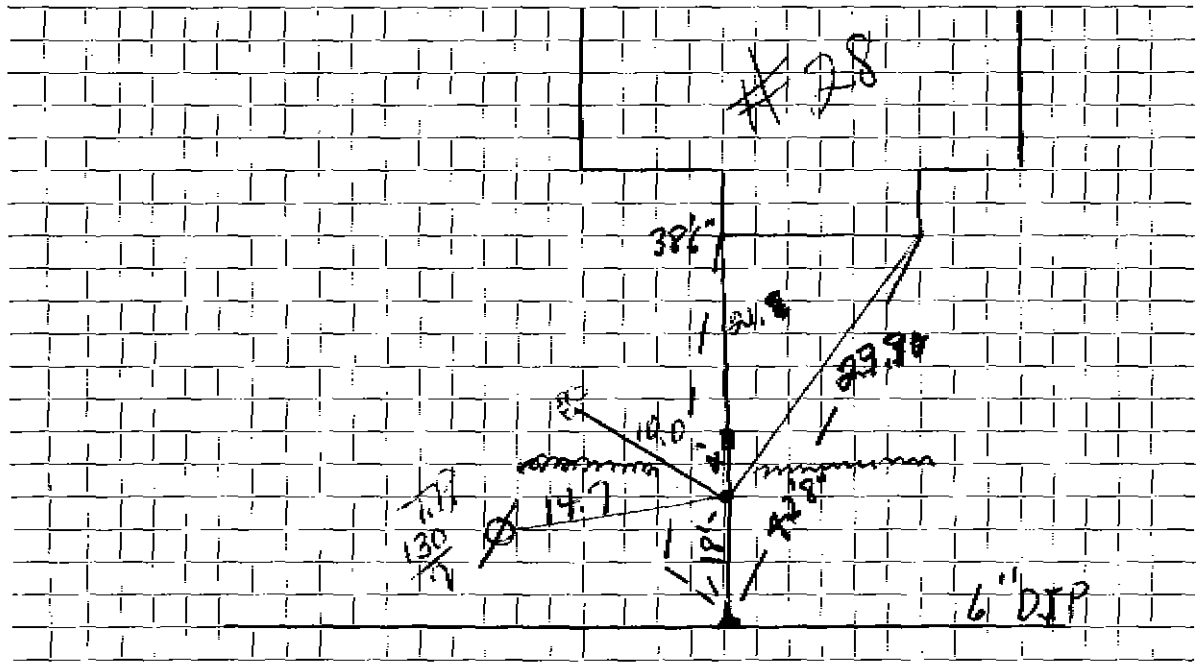

Connection made in ..... Street. Work completed .....

Remarks: CURB 4'-6"-DEEP UNION 5'7"-DEEP