WATER SERVICE RECORD

Name **Service No.**

Address 116 FAIR OAKS TERR

Location

Repair—Renewal—New Service

Date	Material	Amount	Total	Date		Amount
7-20-04	45' - 1" Copper			10-4-47	29' - 3/4" Copper	
	3/4 x 1 - Corp adpt				3/4" CORP	
	1 - Buffalo Box				3/4" Curb	

DATE _____

TOWN OF LEXINGTON — BOARD OF PUBLIC WORKS

WATER DIVISION

Sketch of Service Here

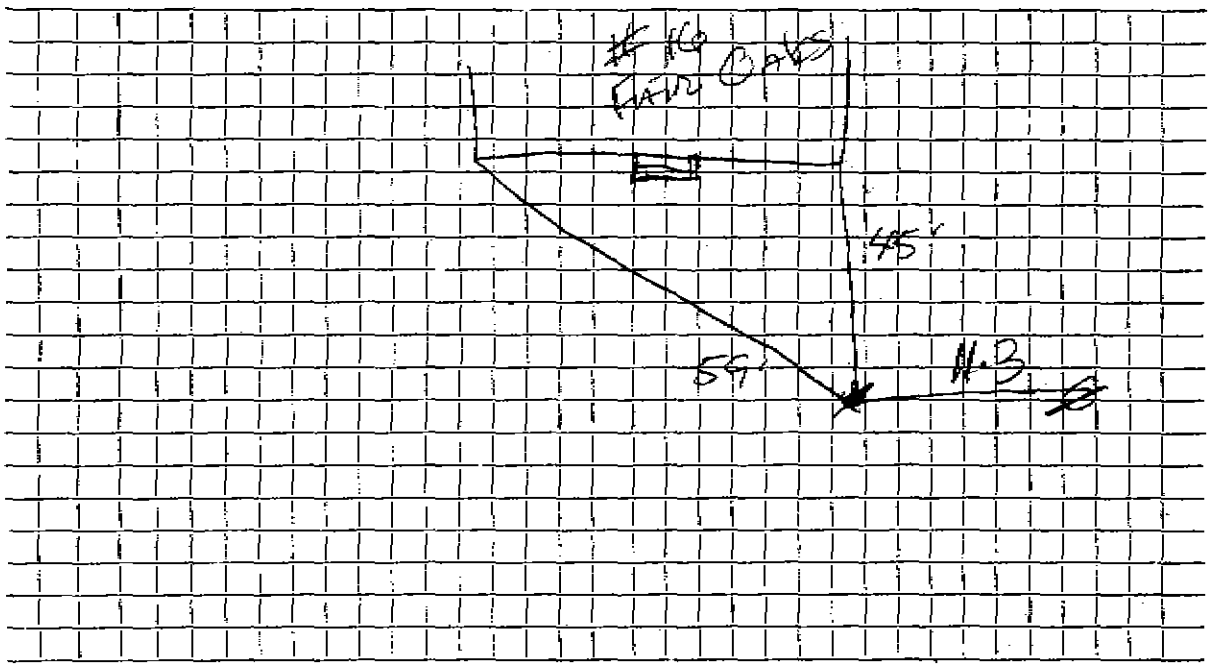

Connection made in ..... Street. Work completed .....

Remarks: .....

.....

.....