F.3.M.16010

WATER SERVICE RECORD

Name Cardinal Associates, Inc. Service No.

Address 10 Fairfield Drive

Location

Repair—Renewal—New Service Lucente #2128

Date	Material	Amount	Total	Date			Amount
8/25/72	43' 3/4" Copper			5/13/70	50'	3/4 COPPER	
					1	3/4 CORP	
					1	3/4 Curb STOP	
						Box & Rod	

DATE

TOWN OF LEXINGTON — BOARD OF PUBLIC WORKS

WATER DIVISION

Sketch of Service Here

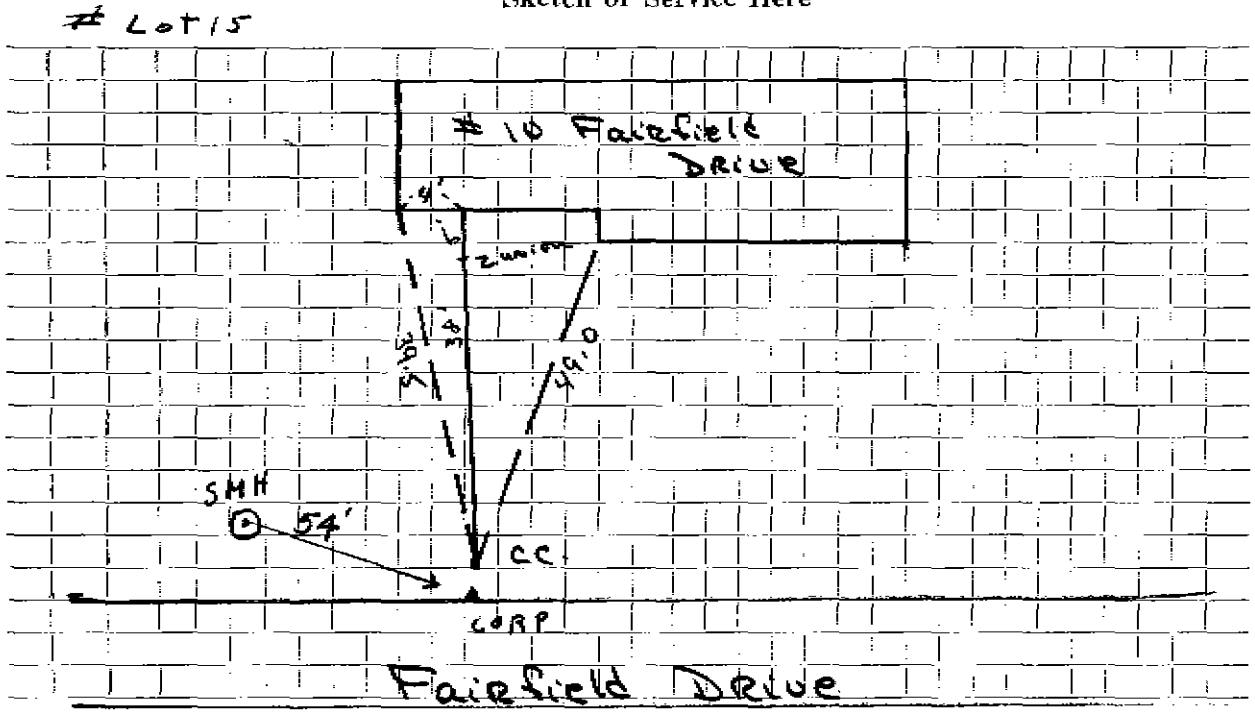

Connection made in ..... Street. Work completed .....

Remarks: 50' From Curb To CORP