S.B.M 46010

WATER SERVICE RECORD

Name Oak Park Corp. **Service No.**

Address 12 Fairfield Drive

Location sta. 6 & 14

Repair—Renewal—New Service Lucente #1591 Lex. Sewerage #2569

Date		Material	Amount	Total	Date		Amount
5-13-70	81'	OUT 3/4" Copper tubing					
9-3-74	38'	3/4" Copper tubing INSIDE					

DATE _____

TOWN OF LEXINGTON -- BOARD OF PUBLIC WORKS

WATER DIVISION

for the ties see next page

Sketch of Service Here

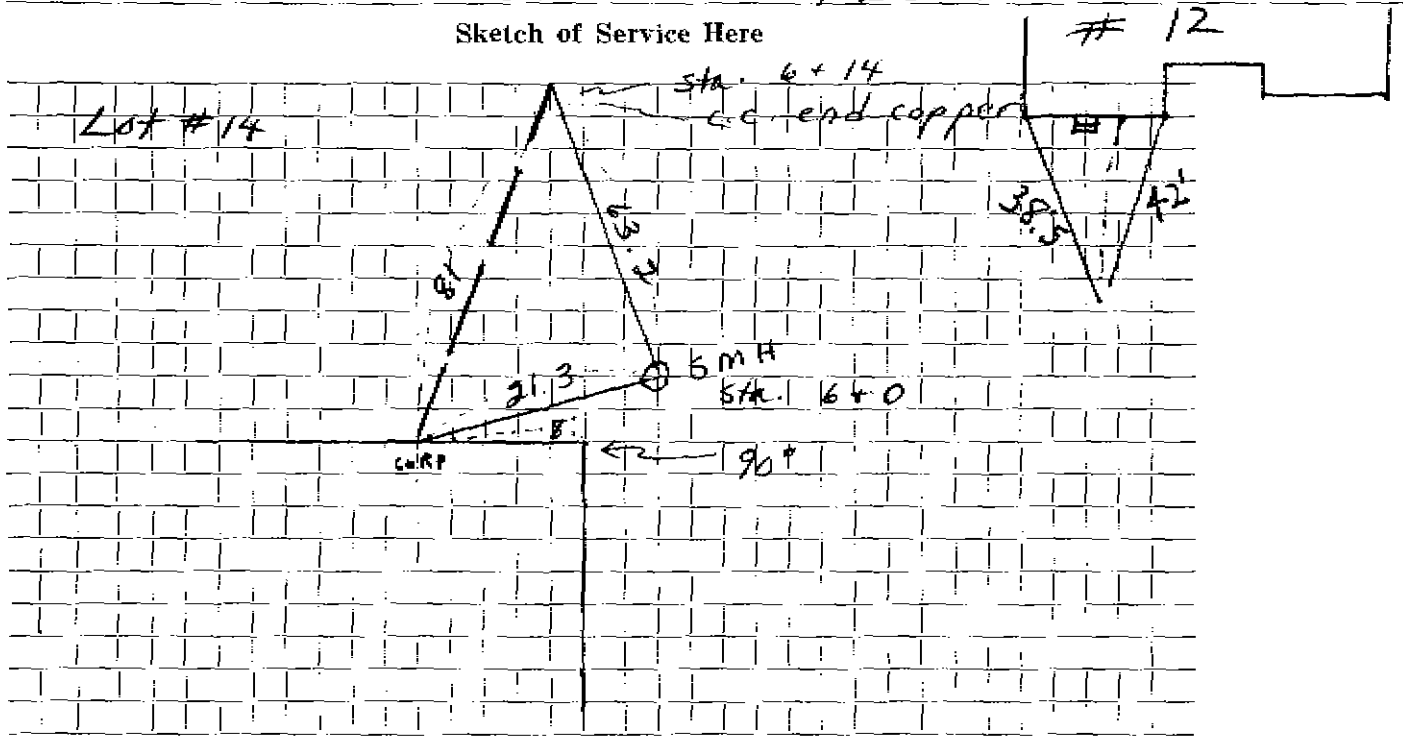

Connection made in ..... Street. Work completed .....

Remarks: .....

.....

.....