CRJ

WATER SERVICE RECORD

Name

Service No.

Address 8 FARM RD LOT #3

Location

Repair—Renewal—New Service

Date	Material	Amount	Total	Date		Amount
3/1/88	75' of 1" COPPER c/C & BOX					

DATE _____

TOWN OF LEXINGTON — BOARD OF PUBLIC WORKS

WATER DIVISION

Sketch of Service Here

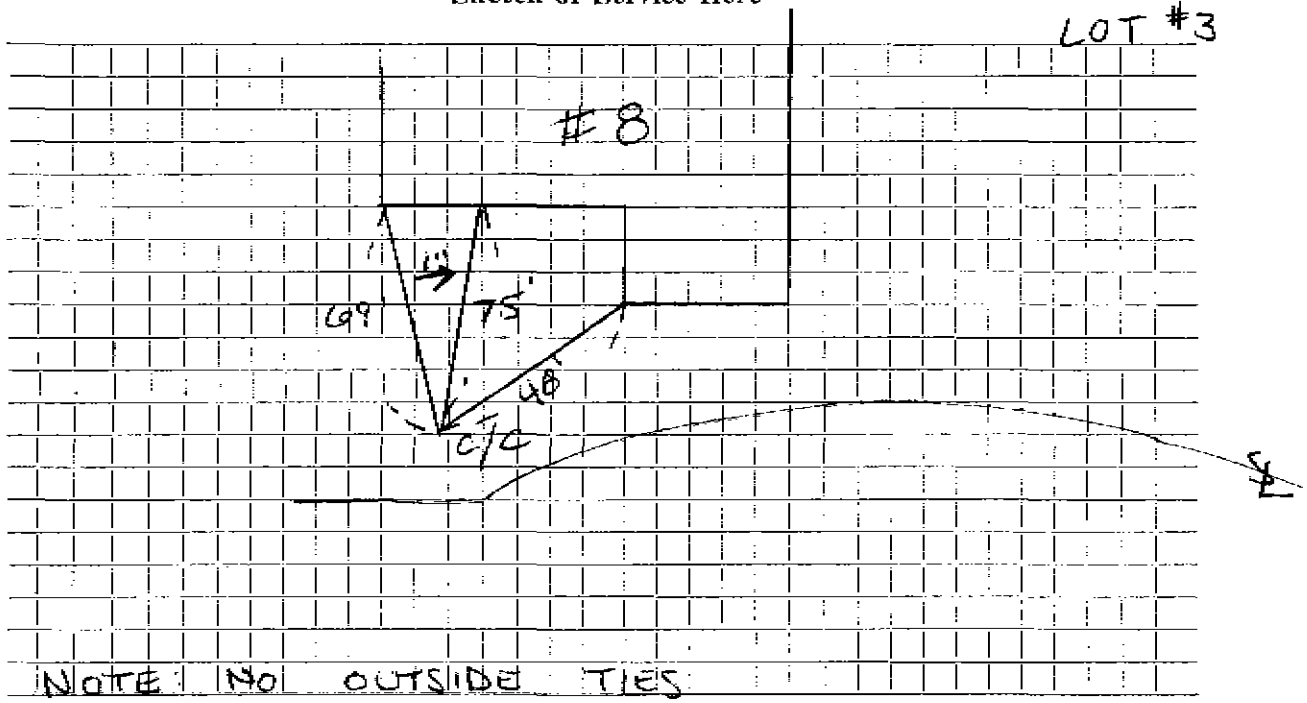

Connection made in FARM RD Street. Work completed .....

Remarks: .....